

Survey Monument Record

CORNER NO. 101
 SECTION 25
 TOWN 5 N
 RANGE 4 W

TYPE OF MONUMENT 3/4" X 24" IRON BAR SET


STATE PLANE COORDINATES: N _____
 E _____

ELEVATION — M.S.L. DATUM: _____

THETA ANGLE: _____

FIELD BOOK: 95-13

PAGE 36

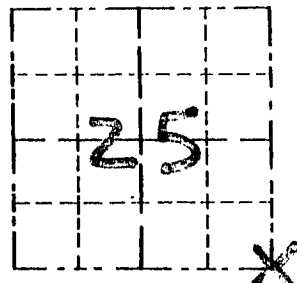

LOCATION
 (Indicated by "X")

BASIS FOR MONUMENT LOCATION


(Use reverse side if necessary)

- 3/4" x 24" IRON BAR SET
- FOR E-W LOCATION A PROJECTION SEAL: OF FENCE REMNANTS FROM THE SOUTH AND A "40" COR. TO NORTH PROPORTIONED N-S LOCATION FROM SW. CORNER OF SEC 36 & THE NW COR. OF SEC. 25. VERIFIED THIS LOCATION BY EDM TRAVERSE OF THE AREA.

CERTIFIED CORRECT
Larry V. Clout
 Registered Land Surveyor
 DATE: 1-8-96

TIE SKETCH

Show at least three (3) ties and monument

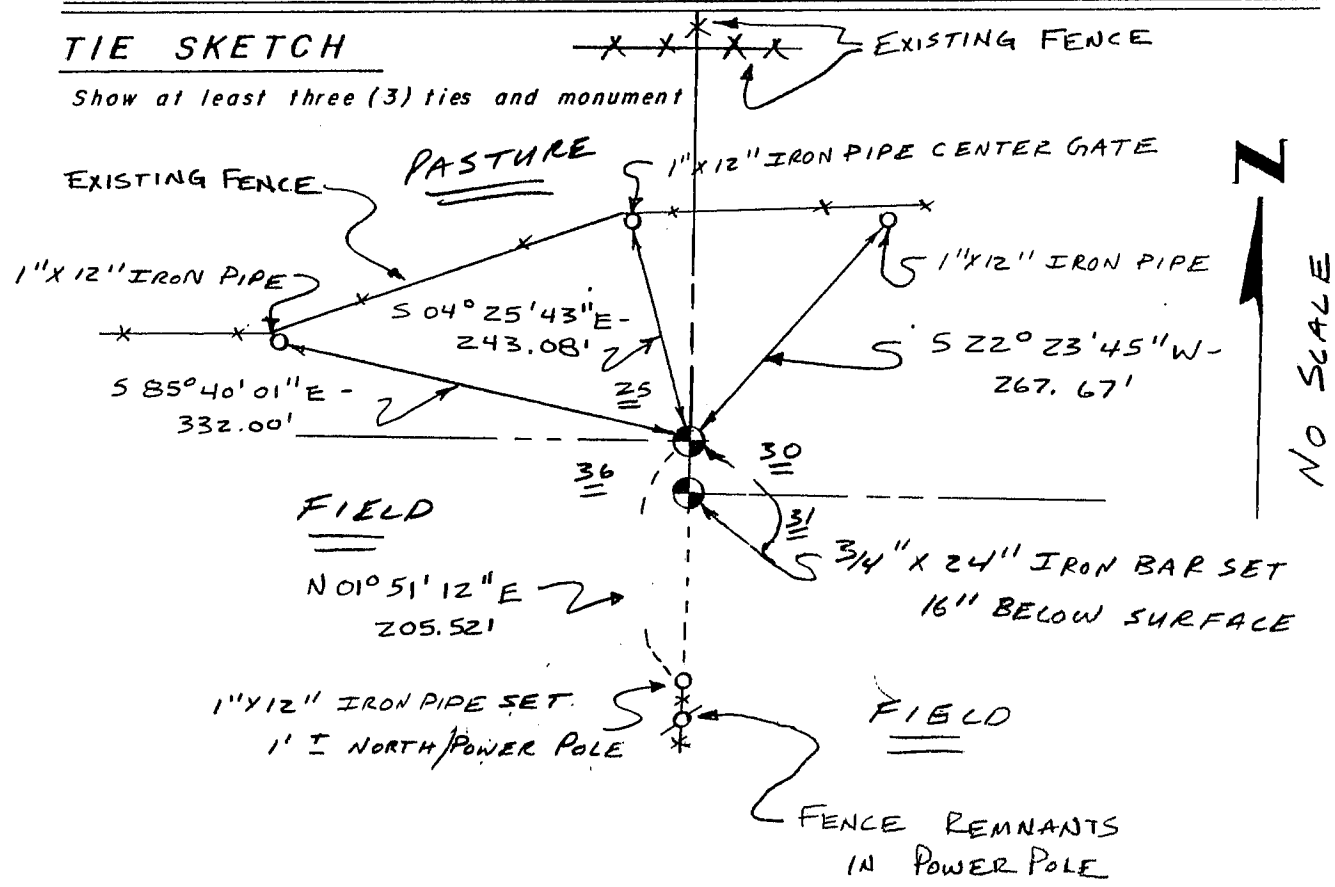

NO SCALE