

Survey Monument Record

CORNER NO. _____

SECTION 36

TOWN T5N

RANGE R4W

TYPE OF MONUMENT 3" PIPE FENCE CORNER


STATE PLANE COORDINATES: N _____
E _____

ELEVATION — M.S.L. DATUM: _____

THETA ANGLE: _____

FIELD BOOK: _____

PAGE _____

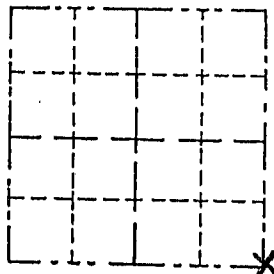

LOCATION
(Indicated by "X")


- FOUND PERPETUATED LOCATION
- OBLITERATED EVIDENCE LOCATION
- LOST CORNER (RESTORED BY PROPORTIONATE METHODS)

BASIS FOR MONUMENT LOCATION

(Use reverse side if necessary)

Show info such as: History of corner, with reference to Vol. and pg., dates, surveyor; exact description of monument replaced; if location computed, by taped or EDM traverse; landowner, remarks, etc.

I HELD THE 3" PIPE FENCE CORNER SET IN CONCRETE AS THE SECTION CORNER AFTER AN E.D.M AND G.P.S. SURVEY OF SECTION 36.

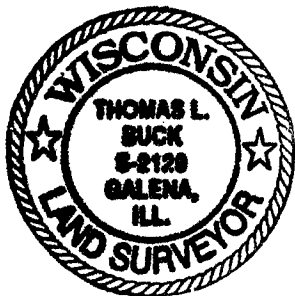


CERTIFIED CORRECT TO THE BEST OF MY KNOWLEDGE AND BELIEF

Thomas L. Buck
Registered Land Surveyor

DATE: 8/9/00

TIE SKETCH

Show at least three (4) ties and monument

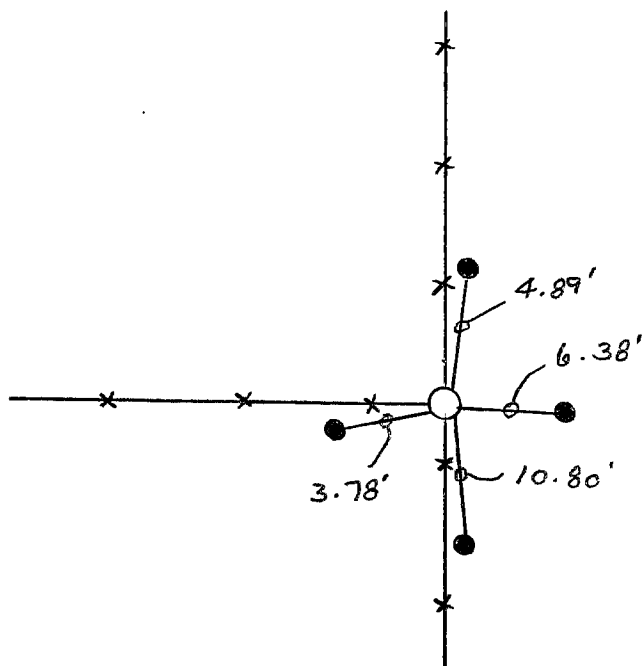

NO SCALE

○ = 3" PIPE FENCE CORNER

● = 5/8" IRON ROD

* * * = EXISTING FENCE