


GRANT COUNTY

Section Summary

18 - T5N - R4W
 SECTION TOWN RANGE

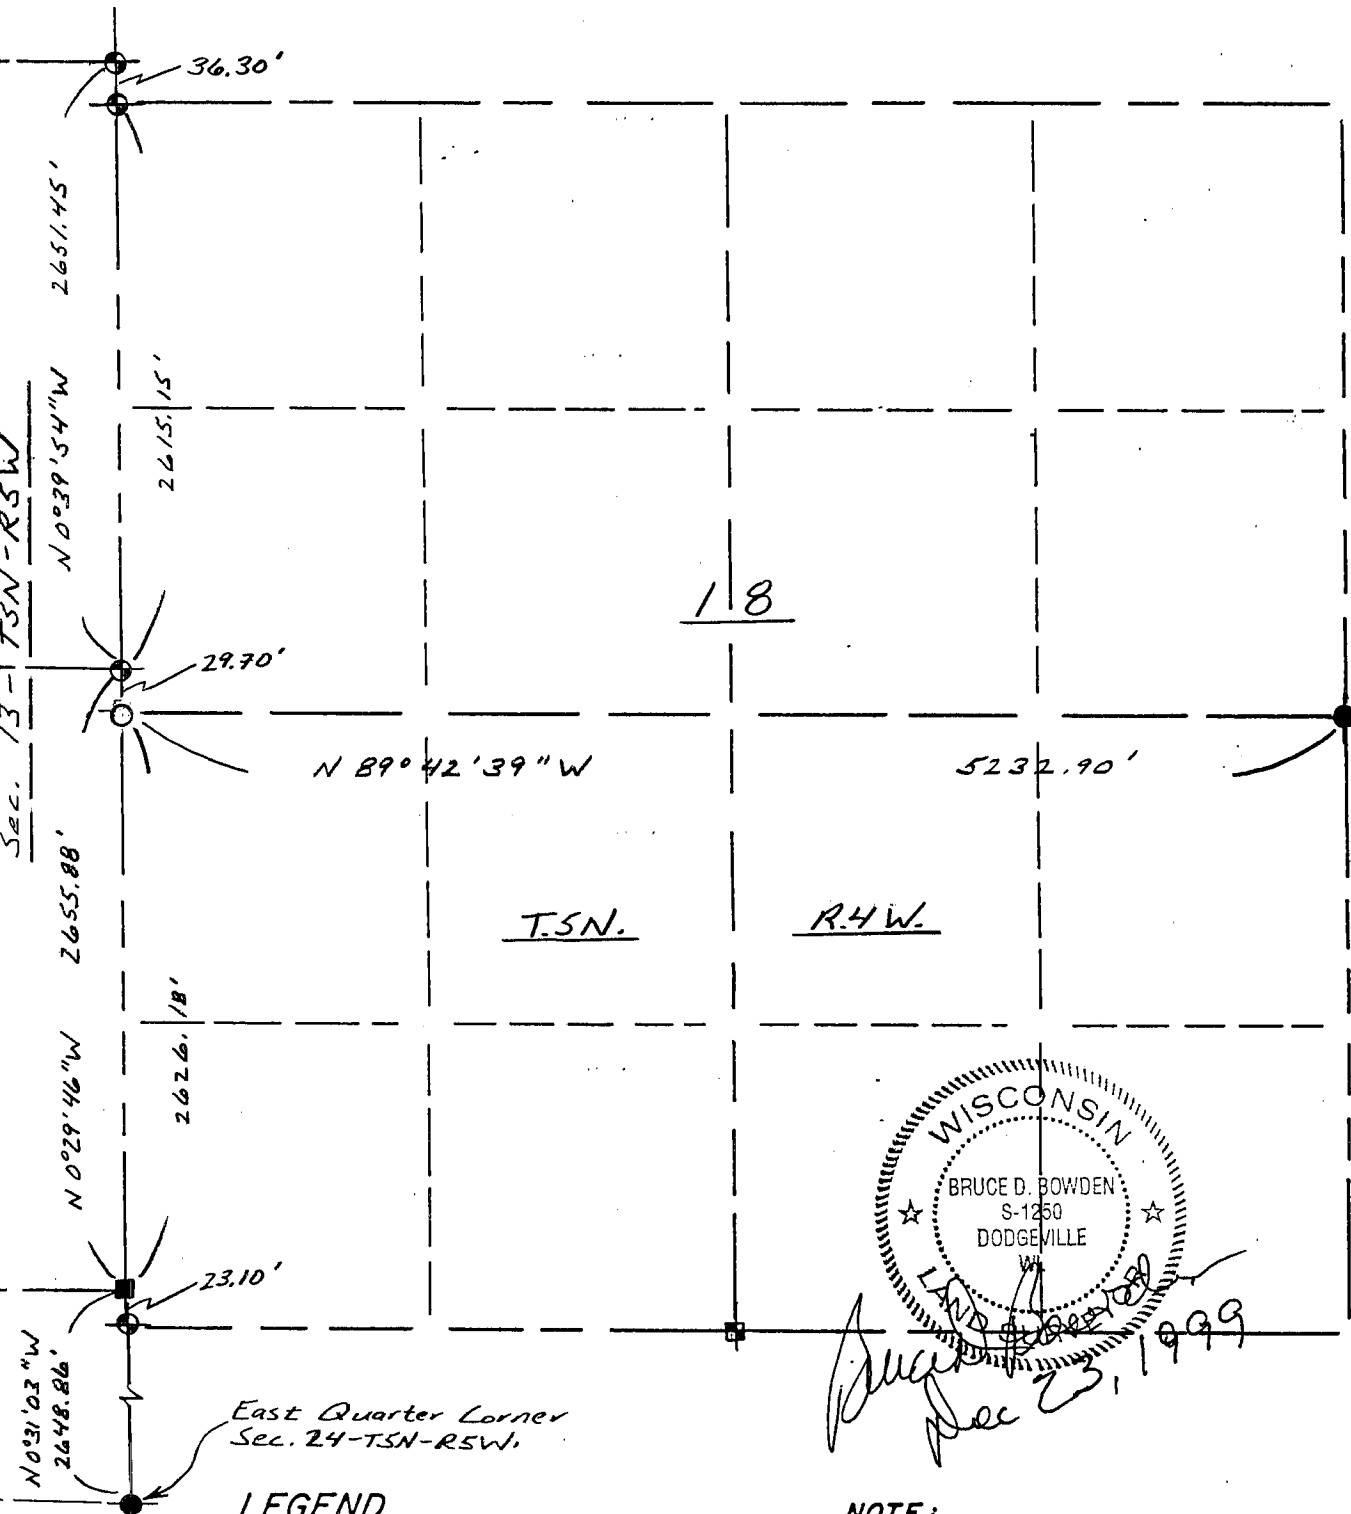

WISCONSIN
 BRUCE D. BOWDEN
 S-1250
 DODGEVILLE
 LAND SURVEYOR
 Dec 23, 1999

LEGEND

- - COUNTY MONUMENT - SET
- - STONE OR CONCRETE MONUMENT - FD
- - OTHER (specify) STONE
MONUMENT - SET
- - 3" x 5" "I" BEAM IN CONCRETE - FD
- - COUNTY MONUMENT - FD

NOTE:

Relationships of all section corners to other section corners shall be shown hereon by bearing and distance or grid coordinates

Show or describe bearing reference

Bearings referenced to Grid North of the Grant Co. Coordinate System as defined by W.D.O.T.