


GRANT COUNTY

Section Summary

36 - 5N - 4W
SECTION TOWN RANGE

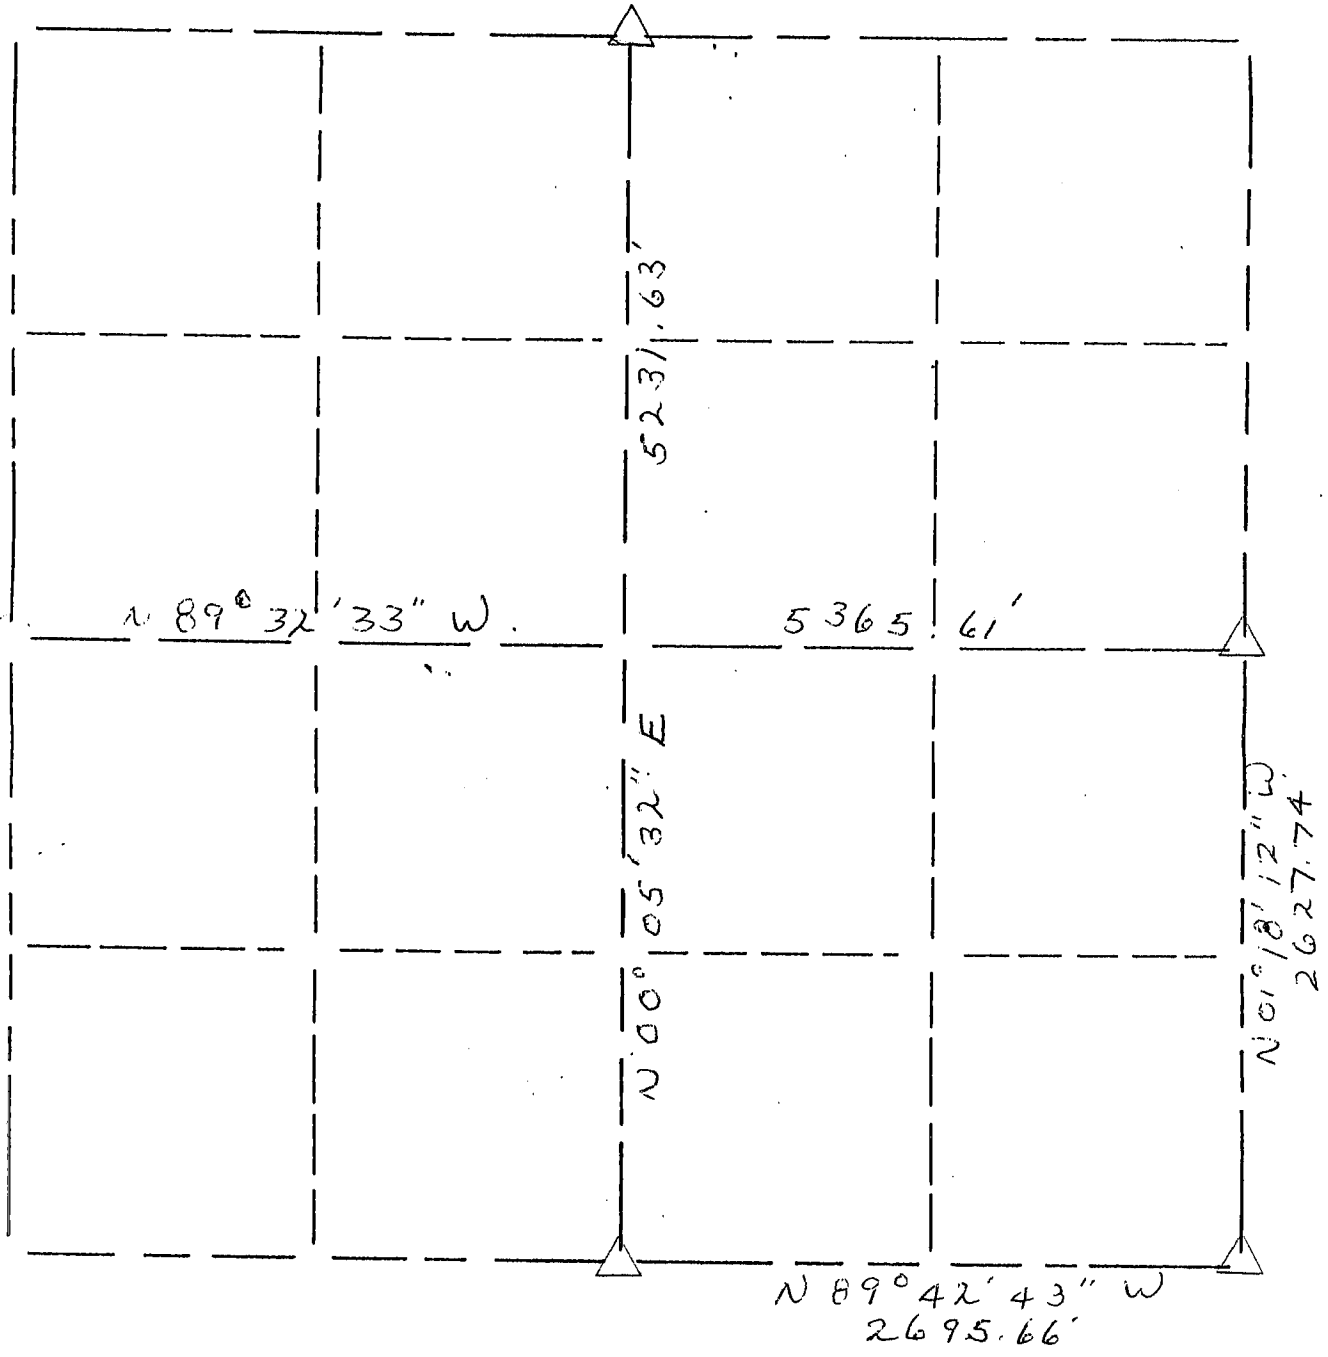

LEGEND

- △ COUNTY MONUMENT
- STONE OR CONCRETE MONUMENT
- OTHER (specify) 3/4\" REBAR FOUND
- _____
- _____
- _____
- _____

NOTE:

Relationships of all section corners to other section corners shall be shown hereon by bearing and distance or grid coordinates

Show or describe bearing reference
 BEARING REFERENCE IS
 GRID NORTH.
 PER GPS OBSERVATION.