


# GRANT COUNTY

## Section Summary

16 - T5N - R5W  
SECTION TOWN RANGE

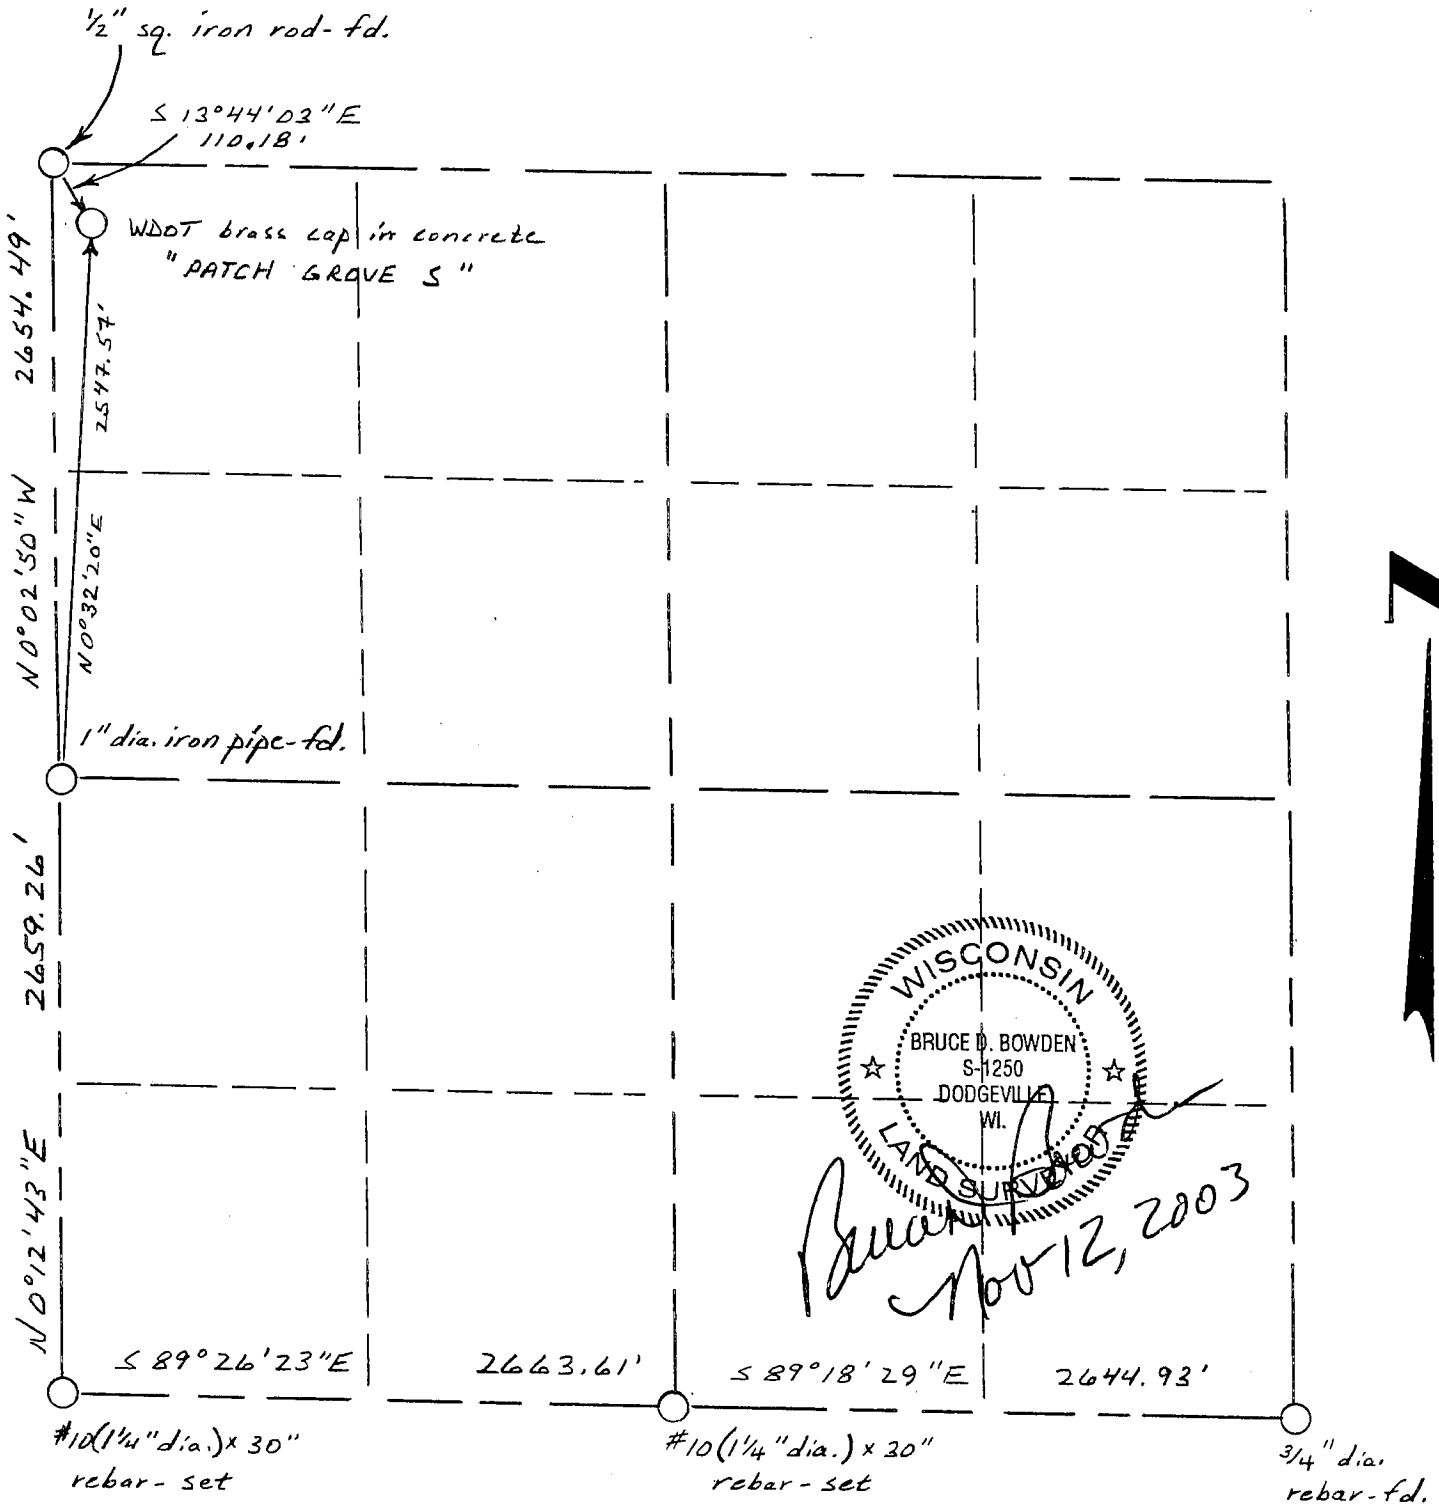

### LEGEND

- △ COUNTY MONUMENT
- STONE OR CONCRETE MONUMENT
- OTHER (specify) \_\_\_\_\_
- \_\_\_\_\_
- \_\_\_\_\_
- \_\_\_\_\_

### NOTE:

Relationships of all section corners to other section corners shall be shown hereon by bearing and distance or grid coordinates

Show or describe bearing reference  
Bearings are referenced to GRID NORTH of the Grant County Coordinate System as defined by the WDOT and determined by GPS observations.