


Survey Monument Record

TYPE OF MONUMENT 3/4" x 24" IRON
BAR SET

CORNER NO. 36
 SECTION 08
 TOWN 5N
 RANGE 6W

FIELD BOOK: 96-06
 PAGE (30)

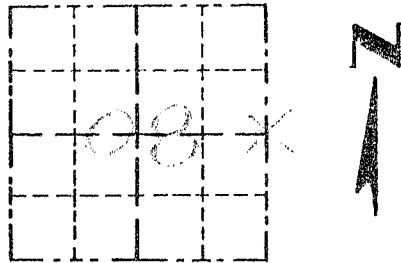

BASIS FOR MONUMENT LOCATION


(Use reverse side if necessary)

Show info such as: History of corner, with reference to Vol. and pg., dates, surveyor; exact description of monument replaced; if location computed, by taped or EDM traverse; landowner, remarks, etc.

LOCATION
 (Indicated by "X")

SEAL:

CORNER SET IN 1832 BY ROBERT CLARK. IN 1878 JOEL BARBER MEASURED TO THE CORNER. IN 1901 K.A. KERST SET A 2" IRON PIPE AT THE CORNER. ACCEPTED THIS LOCATION AFTER EDM TRAVERSE OF AREA.

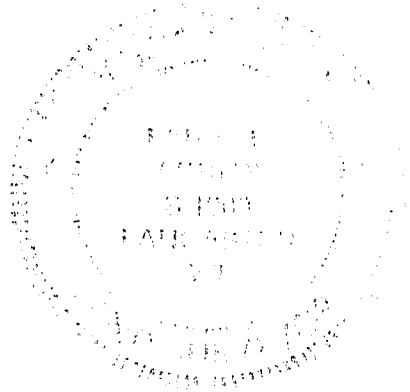

CERTIFIED CORRECT

Kerry J. Aust
 Registered Land Surveyor

DATE: 12-20-97

TIE SKETCH

Show at least three (3) ties and monument

LEGEND

- ⊙ 2" IRON PIPE FOUND
- 1/2" x 15" IRON BAR SET
- EXISTING FENCE

