

# GRANT COUNTY CERTIFIED LAND CORNER

CORNER NUMBER 45

**CERTIFICATE:**


I, Larry L. Austin, do hereby certify that on the 25th day of April, 2000, I found evidence of the Southwest corner of Section 11, Town 5 North, Range 6 West, of the 4th Principal Meridian, and I re-established said corner according to the Wisconsin statutes as shown and described hereon.

Dated this 28th day of April, 2000

*Larry L. Austin*  
Larry L. Austin S-1903



SEAL

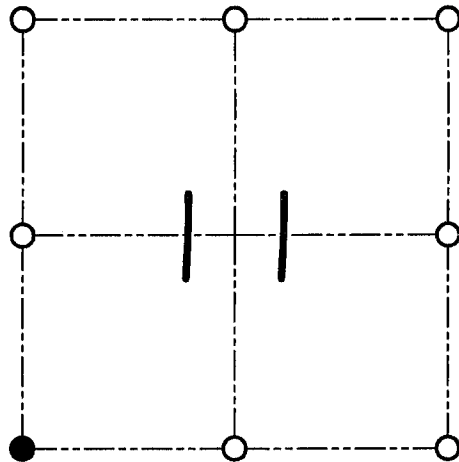

● = CORNER LOCATION

SOUTHWEST CORNER OF  
SECTION 11, T 5 N R 6 W  
TOWN OF WYALUSING

**HISTORY OF ORIGINAL CORNER ESTABLISHMENT:**

Corner was originally set in 1832 by Robert Clark.  
In 1878 Joel Barber set new Bearing trees.

**DESCRIPTION OF CORNER EVIDENCE FOUND:**

I found an existing fence for Easting. Northing was set based on proportionate methods. Verified this location using E.D.M. & G.P.S. methods.

**DESCRIPTION OF CORNER AND WITNESS MONUMENTS, references and accessories used to perpetuate the original or re-established location of this corner**  
WITNESS TO THE CORNER LOCATION: SHELBY BLINDERT & BOBBY SEDGWICK

**SKETCH:**

