


Survey Monument Record

TYPE OF MONUMENT 3/4" x 24" IRON
BAR SET

CORNER NO. 50
 SECTION 08
 TOWN 5N
 RANGE 6W

FIELD BOOK: 96-04
 PAGE 23

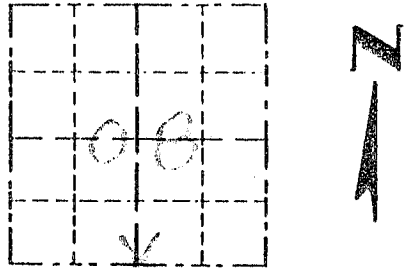

LOCATION
 (Indicated by "X")


BASIS FOR MONUMENT LOCATION

(Use reverse side if necessary)

Show info such as: History of corner, with reference to Vol. and pg, dates, surveyor; exact description of monument replaced; if location computed, by taped or EDM traverse; landowner, remarks, etc.

SEAL:

CORNER SET IN 1832 BY ROBERT CLARK. IN 1878 JOEL BARBER MEASURED TO CORNER. IN 1891 CHARLES SAMPSON FOUND ONE BEARING TREE. I FOUND A 3/4" IRON BAR AT THE CORNER, ACCEPTED ITS LOCATION AFTER AN EDM TRAVERSE OF AREA.

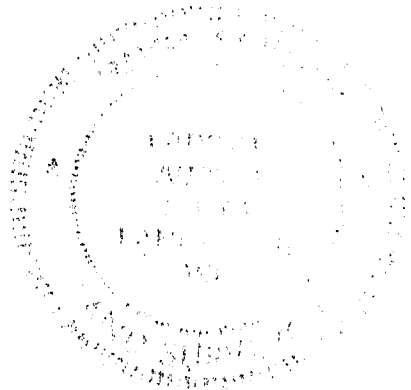


CERTIFIED CORRECT

Randy S. Aust
 Registered Land Surveyor

DATE: 12-20-97

TIE SKETCH

Show at least three (3) ties and monument

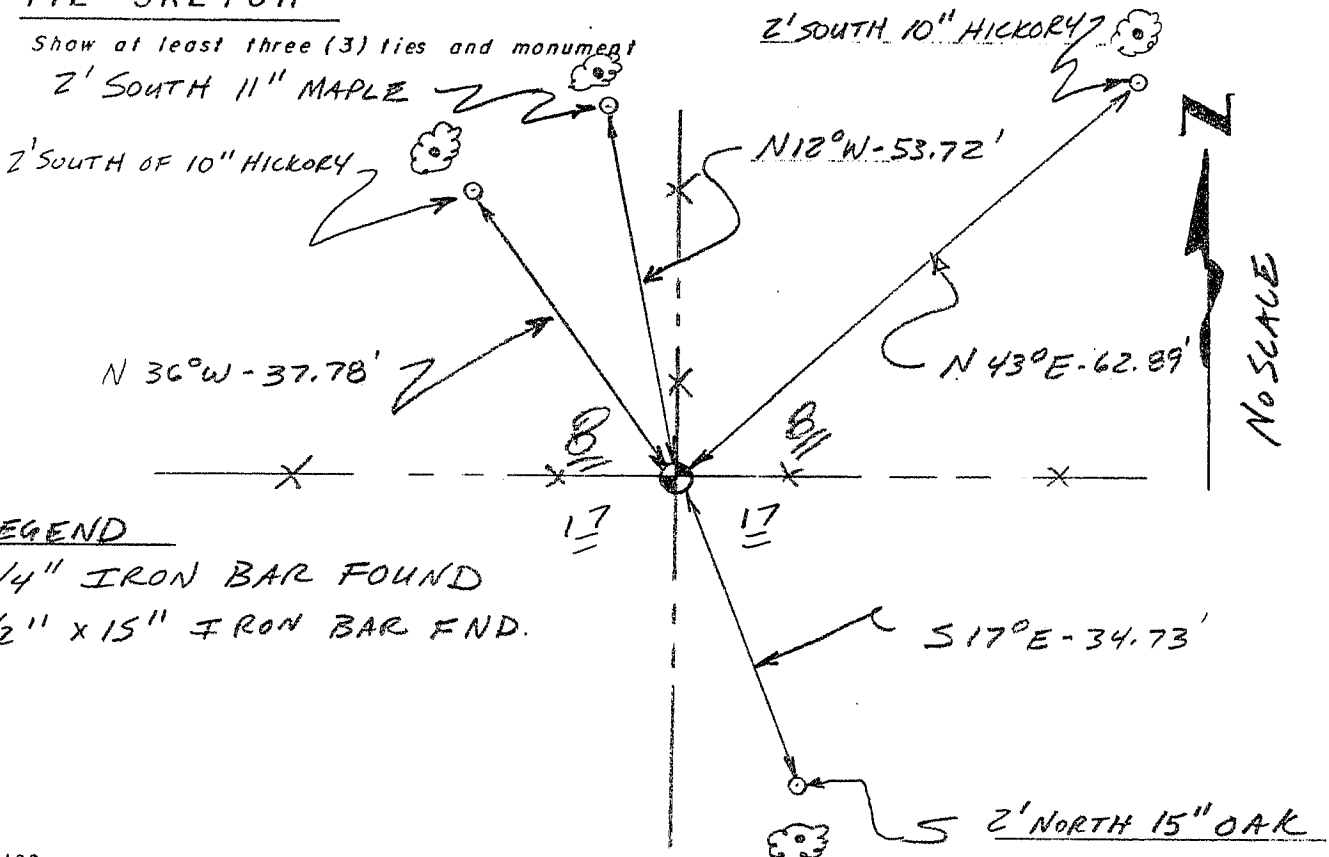

LEGEND

- ⊙ 3/4" IRON BAR FOUND
- 1/2" x 15" IRON BAR FND.