


GRANT COUNTY

REC'D FEB 11 1998

Survey Monument Record

CORNER NO. 122
 SECTION 36
 TOWN 5N
 RANGE 6W

TYPE OF MONUMENT 24" x 3/4" Iron Rod
 STATE PLANE COORDINATES: N _____
 E _____
 ELEVATION — M.S.L. DATUM: _____
 THETA ANGLE: _____
 FIELD BOOK: _____
 PAGE _____

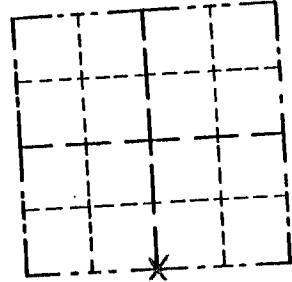

LOCATION
(Indicated by "X")

BASIS FOR MONUMENT LOCATION

(Use reverse side if necessary)

Show info such as: History of corner, with reference to Vol. and pg., dates, surveyor; exact description of monument replaced; if location computed, by taped or EDM traverse; landowner, remarks, etc.

SEAL:

SEE TIE SHEET
FOR N 1/4 1-4-6

Monument set from existing physical evidence after verification by proportionate measurements from an EDM traverse of the area and GPS observations.


CERTIFIED CORRECT

Thomas Bueh
Registered Land Surveyor

DATE: 2/5/98

TIE SKETCH

Show at least three (3) ties and monument

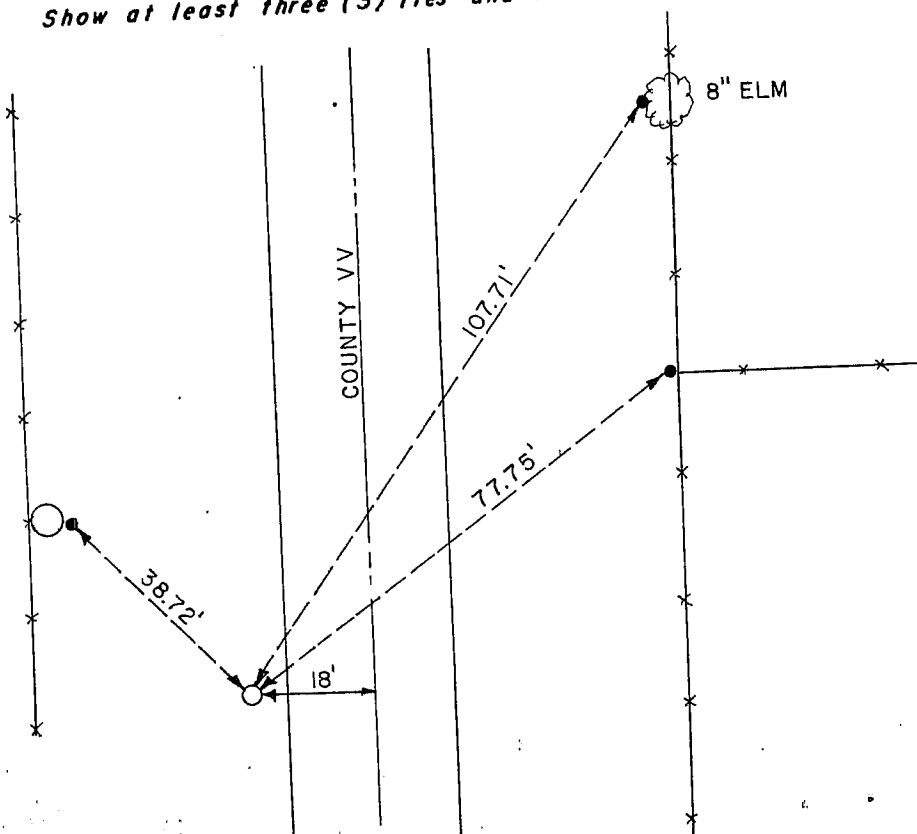

- = POWER POLE
- = 3/4" x 24" IRON ROD
- = 1/2" x 18" IRON ROD
- *- = EXISTING FENCE