


# Survey Monument Record

CORNER NO. \_\_\_\_\_  
 SECTION 36  
 TOWN 5 NORTH  
 RANGE 6 WEST

TYPE OF MONUMENT 3/4" x 24" Iron Rod  
 STATE PLANE COORDINATES: N \_\_\_\_\_  
 E \_\_\_\_\_  
 ELEVATION — M.S.L. DATUM: \_\_\_\_\_  
 THETA ANGLE: \_\_\_\_\_  
 FIELD BOOK: \_\_\_\_\_  
 PAGE \_\_\_\_\_

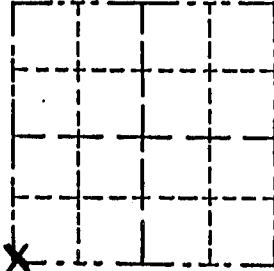

LOCATION  
 (Indicated by "X")


- FOUND PERPETUATED LOCATION
- OBLITERATED EVIDENCE LOCATION
- LOST CORNER (RESTORED BY PROPORTIONATE METHODS)

## BASIS FOR MONUMENT LOCATION

(Use reverse side if necessary)

Show info such as: History of corner, with reference to Vol. and pg., dates, surveyor; exact description of monument replaced; if location computed, by taped or EDM traverse; landowner, remarks, etc.

I FOUND NO HISTORY OF THIS CORNER SINCE THE ORIGINAL GOVERNMENT SURVEY. I SET THIS CORNER AT THE FENCE CORNER AFTER VERIFICATION BY PROPORTIONATE MEASUREMENTS FROM AN E. D. M. TRAVERSE AND G. P. S. OBSERVATIONS IN SECTION 36 AND PART OF 25 & 35.

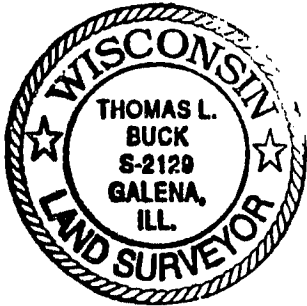


CERTIFIED CORRECT TO THE BEST OF MY KNOWLEDGE AND BELIEF

Thomas L. Buck  
 Registered Land Surveyor

DATE: 10/16/98

## TIE SKETCH

Show at least three (3) ties and monument

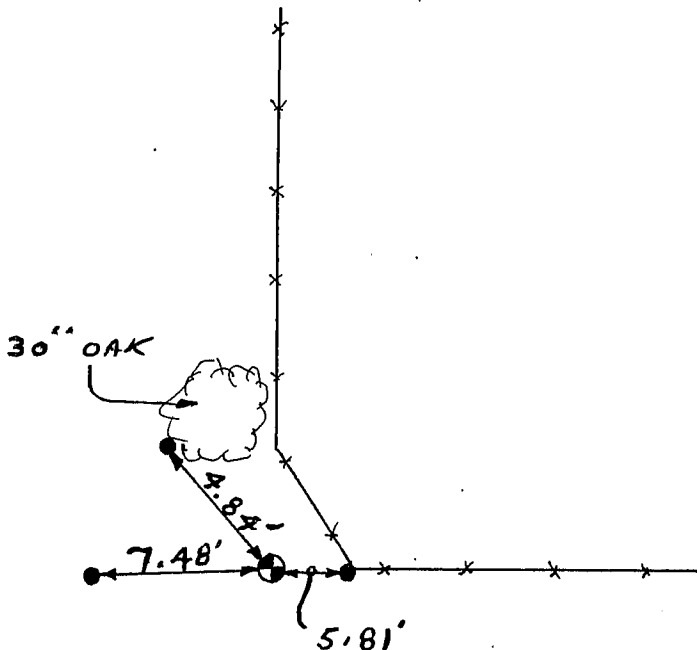

NO SCALE

LEGEND

⊙ = 3/4" x 24" Iron Rod

● = 1/2" IRON ROD

—x—x— = EXISTING FENCE