


SECTION CORNER TIE SHEET INDEX

T. 6 N., R. 1 W

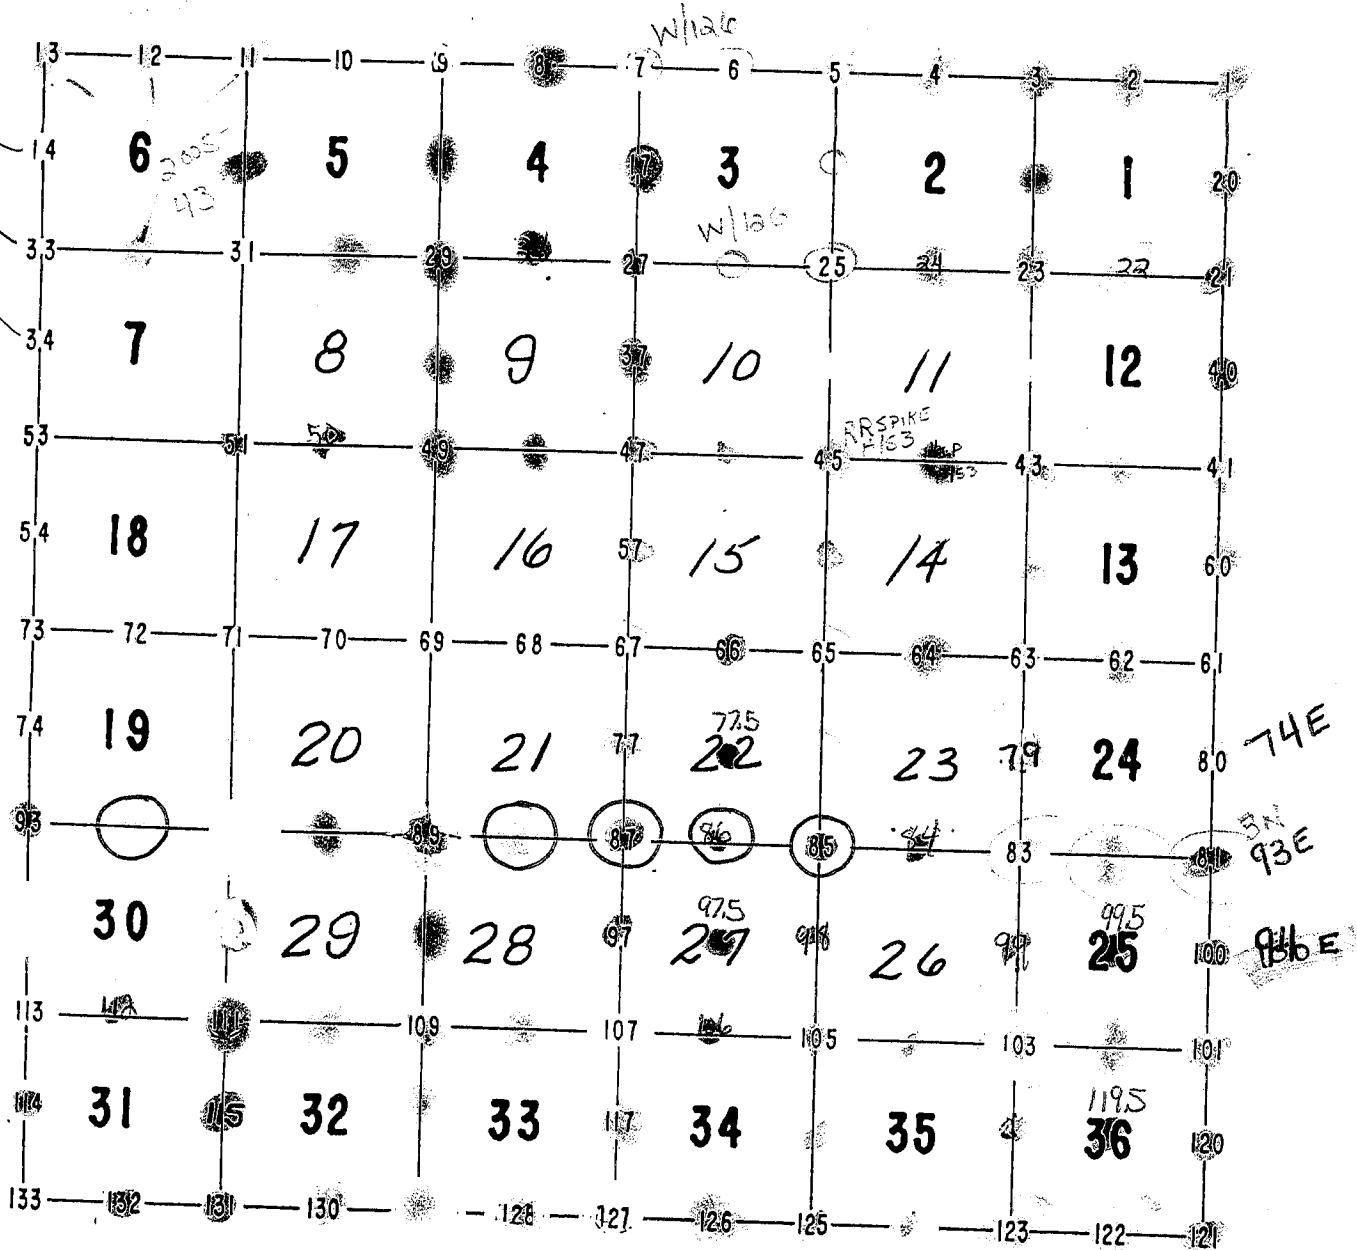

30 823.7
179769.3

133 - 7-1 E I.C.

292463.487
18683.515

33

60

53-530WA
1-1-12