

61069


U.S. PUBLIC LAND SURVEY MONUMENT RECORD

Wisconsin Department of Transportation

DT1291 2/2006


County Name <b>Grant</b>		Name of <input checked="" type="checkbox"/> Township, <input type="checkbox"/> City, <input type="checkbox"/> Village <b>Wingville</b>	
Surveyor Name <b>Michael T. Schinke</b>			
Address, City, State, ZIP Code <b>7501 College Blvd Suite 101 Overland Park, KS 66210</b>			
Y (Northing) <b>360518.4870</b>	X (Easting) <b>1832636.528</b>	Latitude	Longitude
Project ID <b>0020543.00</b>		Coordinate ID	

T. 6 N. - R. 1 W  
4<sup>th</sup> Principal Meridian  
Corner **69**

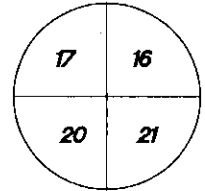


- HORIZONTAL DATUM UNITS
- NAD 27
  - NAD 83 (1991)
  - NAD 83 (1997)
  - Other— NAD 83 (2011)
  - English
  - Metric

- COORDINATE SYSTEM
- Geodetic
  - State Plane South Zone
  - County

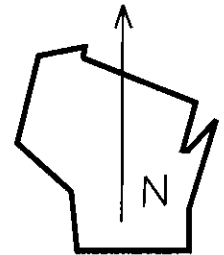

Location Diagram, showing corner identification name, bearing and distance references to at least four witness monuments, fence or occupational lines, centerlines of roads, and other site details for reference. Also, show the bearings and distances between the witness monuments.

Northeast Corner Section 20, Township 6 North, Range 1 West, Grant County, Wisconsin

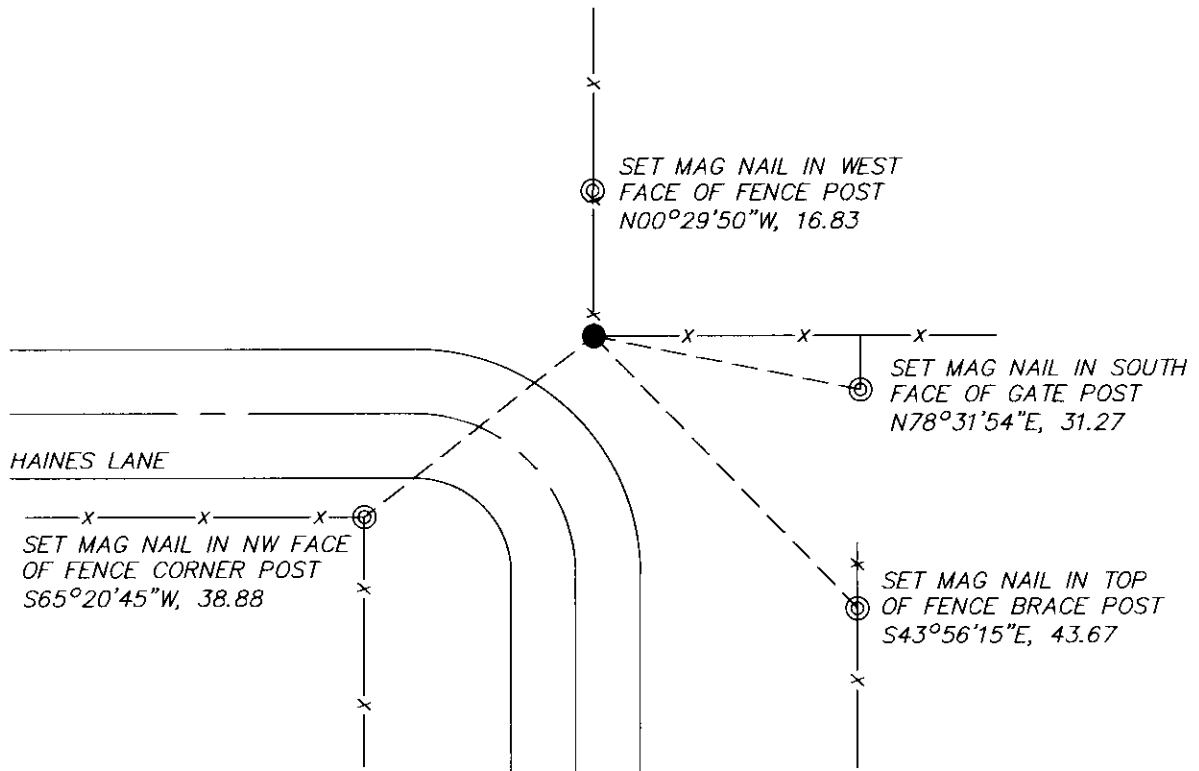

Indicate fd. = found or pl. = placed in the diagram below  
Bearings used in the location sketch and basis for monument location are assumed, unless as noted.  
Monumentation Legend / Description of Corner and Witness Monuments.


- ⊙ SET MAG NAIL
- SET NO. 6 REBAR, 18" LONG, AT BASE OF FENCE CORNER POST

If applicable, show any discrepancy between the location of the corner as restored or re-established and the location of that corner as previously restored or re-established by bearing and distance. Also, show the bearings and distances between the previous corner and at least two of the witness monuments.

Basis for Monument Location

1. Describe any record evidence, monument evidence, occupational evidence or any other material evidence including traverse measurements that you considered, and whether the monument was found or placed. Explain below, be specific, and attach a separate sheet if necessary.
  
2. Was the corner.
  - a. found perpetuate
  - b. restored through acceptance of obliterated evidence.
  - c. relocated by witness testimony, or
  - d. accepted as a re-monumented corner of record and maintained with additional monumentation?
  
3. Was the corner re-established through lost corner proportionate methods? If so, show the method, including the directions and distances to other public land survey corners used as evidence or used in determining the corner location.
  1. Westwood Professional Services searched the area and found no monument. No other evidence of the corner position was found while conducting research. There is a fence line in the area that runs North and East. This fence corner fits GLO distances within reason. Holding the fence corner for the N/E fence line as the best available evidence of the corner. Set a 3/4" x 18" rebar at the base of the corner post as the corner position and set 4 ties.
  2. B
  3. NO


T. 6 N. R. 1 W.  
4 th Principal Meridian  
Corner 69

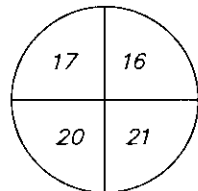

Certification

I, Michael T. Schinke, certify that the corner location shown on the record was determined by me or under my direction and control and that the U.S. Public Land Survey Monument Record is correct and complete to the best of my knowledge and belief, in accordance with Chapter A-E 7.08 of the Wisconsin Administration Code.

Section Control Data Sheets have been filed in the County Surveyor's office, showing final measurements by direction and distance between all re-monumented corners. Section Control information is referenced by the following.

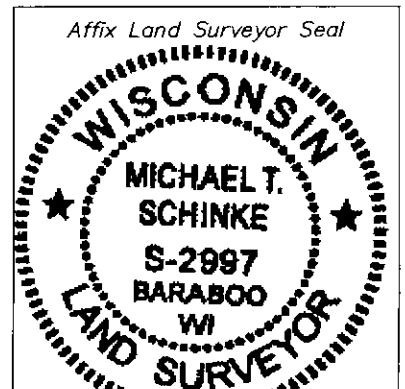

Date	Project ID	Sheet(s)
	0020543.00	2 of 2

x Michael T Schinke  
(Registered Land Surveyor Signature and Number)

04/23/2020

Date