

U. S. PUBLIC LAND SURVEY MONUMENT RECORD


INSTRUCTIONS:

This record shall show the location of the corner and shall include all of the following nine elements (a through i).

- (a) Identify the corner by reference to the U.S. public land survey system.

⊙ = Corner monument restored.

NORTHWEST CORNER OF
SECTION 12, TOWN 6 NORTH,
RANGE 1 WEST, WINGVILLE
TOWNSHIP, GRANT COUNTY,
WISCONSIN.

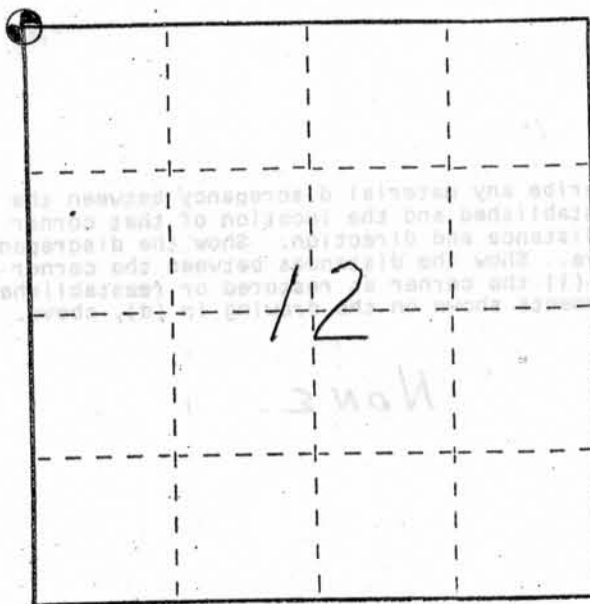


- (b) Describe any record evidence, monument evidence, occupational evidence, testimonial evidence or any other material evidence you considered, and whether the monument was found or placed.

CORNER IS AS DESCRIBED ON TWO PREVIOUS MONUMENT RECORDS.
MONUMENTS HAVE BEEN DISPLACED DUE TO EROSION THAT
HAS CREATED A GULLY WHICH WILL CONTINUALLY GROW LARGER.
ADDITIONAL TIES HAVE BEEN ADDED AS SHOWN.

- (c) In the plan view drawing below, provide reference ties to at least 4 witness monuments, or, if the location is within a municipality, to at least 2 witness monuments. (Witness monuments shall be made of concrete, natural stone, iron or other equally durable material, ~~except~~ wood.) Describe witness monuments.

NO MONUMENT AT CORNER.


- (d) Show a plan view drawing depicting the relevant monuments and reference ties which is sufficient in detail to enable accurate relocation of the corner monument if the corner monument is disturbed. Indicate north.

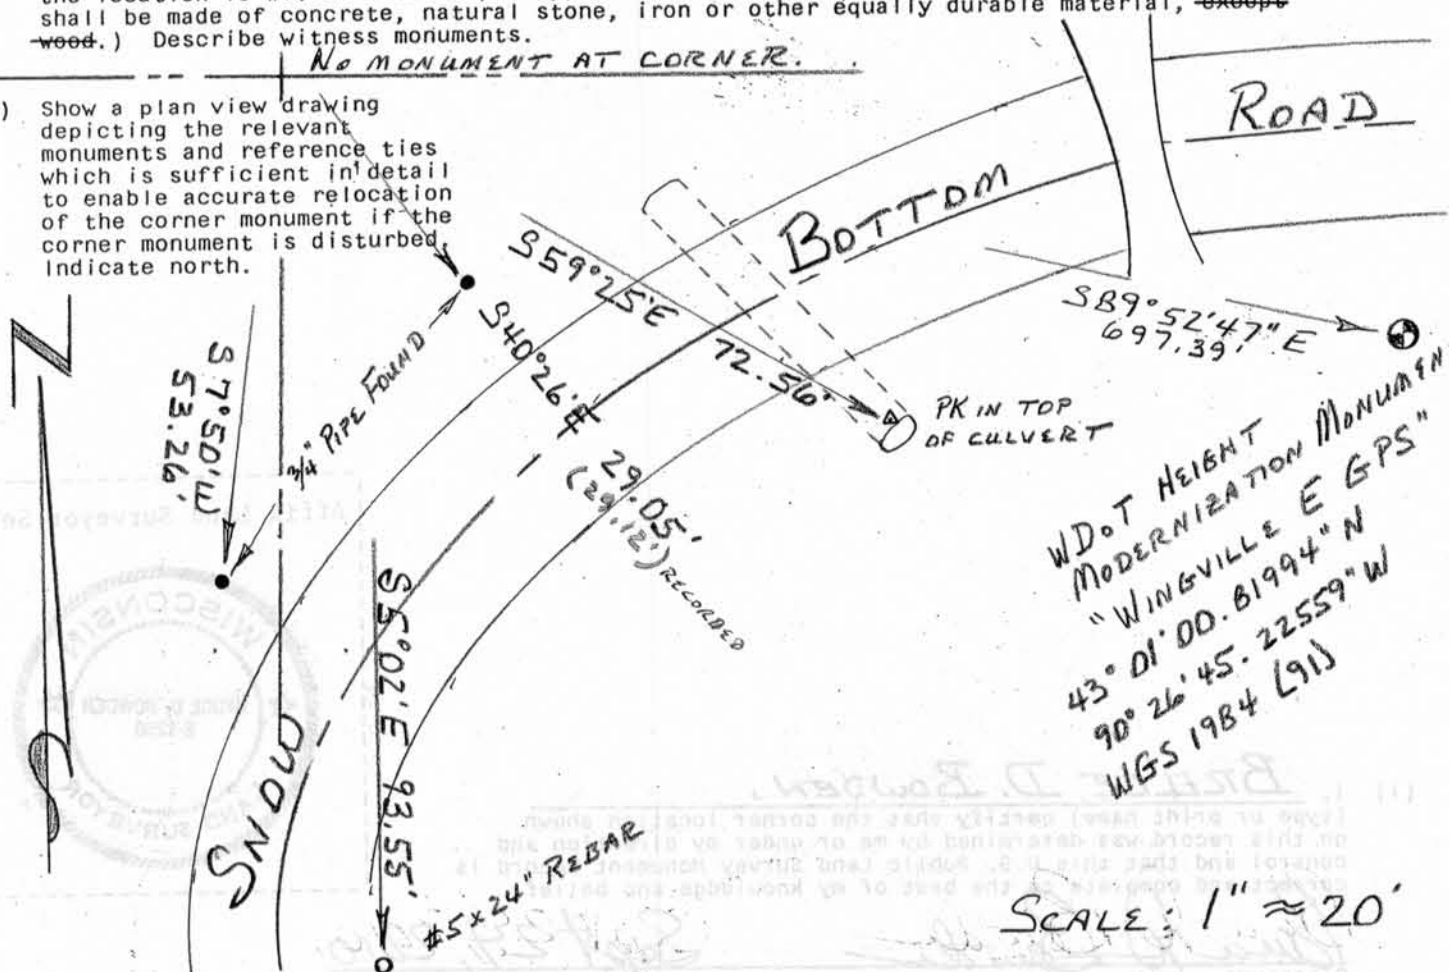

SEP 30 2010

U. S. PUBLIC LAND SURVEY MONUMENT RECORD

This record shall show the location of the corner and shall include all of the following items (a) through (i).

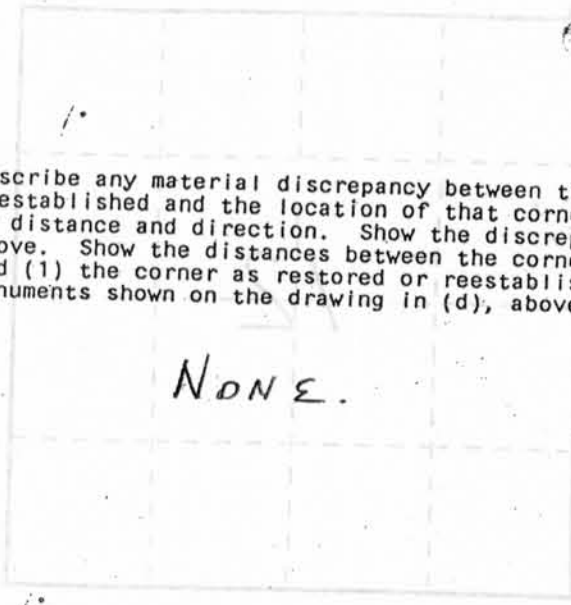

- (e) Describe any material discrepancy between the location of the corner as restored or reestablished and the location of that corner as previously restored or reestablished by distance and direction. Show the discrepancy on the plan view drawing under (d), above. Show the distances between the corner as previously restored or reestablished and (1) the corner as restored or reestablished, and (2) to at least 2 of the witness monuments shown on the drawing in (d), above.

NONE.

- (f) Was the corner restored through acceptance of (1) an obliterated evidence location, or, (2) a found perpetuated location?

(2) A FOUND PERPETUATED LOCATION

- (g&h) Was the corner reestablished through lost corner proportionate methods? If so, show the method, including the directions and distances to other public land survey corners used as evidence or used for proportioning in determining the corner location?

No

Affix Land Surveyor Seal



(i) BRUCE D. BOWDEN

(type or print name) certify that the corner location shown on this record was determined by me or under my direction and control and that this U.S. Public Land Survey Monument Record is correct and complete to the best of my knowledge and belief.

Bruce D. Bowden
Signature

Sept 24, 2010
Date

U.S. PUBLIC LAND SURVEY MONUMENT RECORD

(AS REQUIRED BY s.A-E 7.08, WI. ADM. CODE)

HISTORY OF ORIGINAL CORNER ESTABLISHMENT AND SUBSEQUENT RESTORATIONS AND DESCRIPTION OF ANY RECORD, MONUMENT, OCCUPATION, TESTIMONIAL OR OTHER EVIDENCE CONSIDERED

CORNER MONUMENT AND ALL TIES WERE DESTROYED IN THE AREA
RESTORED TO BRUCE BOWDEN LOCATION PER SKETCH BELOW.

COORDINATES ARE ESTABLISHED TO THE CORNER AND WITNESS TIES AS SHOWN BELOW

BEARING REFERENCE AND COORDINATES ARE GRANT COUNTY COORDINATE SYSTEM
NAD 83(91) ENGLISH SYSTEM

CORNER WAS: (CHECK ALL THAT APPLY)


- ☒ RESTORED THROUGH ACCEPTANCE OF AN OBLITERATED EVIDENCE LOCATION
- ☐ RESTORED THROUGH ACCEPTANCE OF A FOUND PERPETUATED LOCATION
CONSIDERED A LOST CORNER AND REESTABLISHED THROUGH LOST CORNER PROPORTIONATE METHODS
(INCLUDE A PLAN VIEW DRAWING SHOWING BEARING & DISTANCE TO OTHER PUBLIC LAND SURVEY CORNERS)
- ☐ USED FOR PROPORTIONING AND DETERMINING THE CORNER LOCATION
- ☐ RESTORED OR REESTABLISHED IN A LOCATION THAT DIFFERS FROM A PREVIOUS RESTORATION OR REESTABLISHMENT
(INCLUDE A PLAN VIEW DRAWING AND INDICATE WHAT WAS SET AND/OR FOUND)

Describe the monument and accessories used to perpetuate the location of the corner. (include a plan view drawing and indicated what was set and/or found)

LEGEND:

- △ SET 3/4"Φ IRON PIPE
- FOUND STONE MONUMENT
- ⊠ FOUND 6' TALL ANGLE IRON SET IN CONC.
- ⊞ SET 7/8"X24" REBAR
- () RECORDED AS
- ⊗ SET "PK" NAIL
- x—x— FENCE
- ▲ FOUND 1" IRON PIPE

SECT 2 TOWN 6 N RANGE 1W	SECT 1 TOWN 6 N RANGE 1W
SECT 11 TOWN 6 N RANGE 1W	SECT 12 TOWN 6 N RANGE 1W

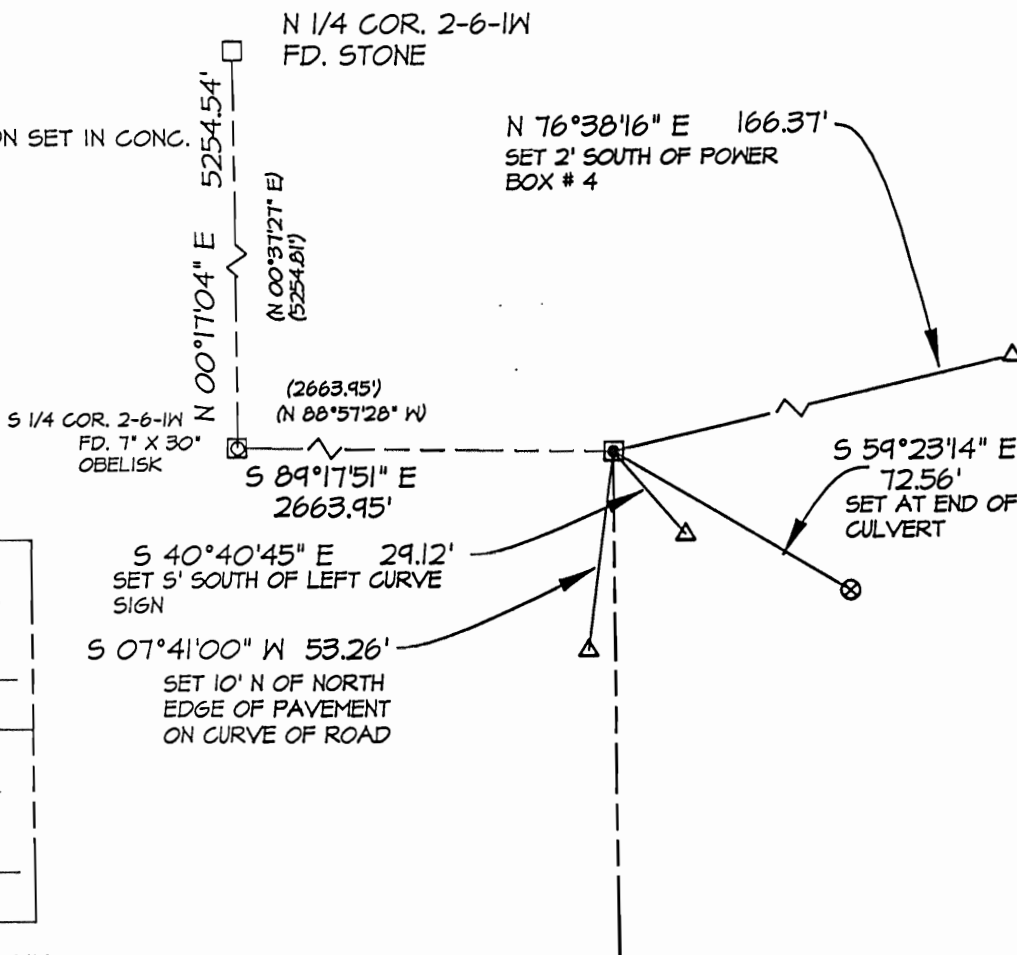

● = LOCATION OF CORNER

THE SE COR. OF SECT 2 T 6 N, R 1W

THE SW COR. OF SECT 1 T 6 N, R 1W

THE NW COR. OF SECT 12 T 6 N, R 1W

THE NE COR. OF SECT 11 T 6 N, R 1W

GRANT COUNTY, WISCONSIN

JOB ID: 085-084 BOOK #: 2008-3 P.56

I, LAURENCE E SCHMIT CERTIFY THAT THE CORNER LOCATION SHOWN ON THIS
RECORD WAS DETERMINED BY ME OR UNDER MY DIRECTION AND CONTROL
AND THAT THIS U.S. PUBLIC LAND SURVEY MONUMENT RECORD IS CORRECT
AND COMPLETE TO THE BEST OF MY KNOWLEDGE AND BELIEF.

Laurence E Schmit

SIGNATURE

revised 5-19-09

DATE:

SCALE: 1" = 50'



LAND SURVEYORS SEAL

INDEX NUMBER 23

U.S. PUBLIC LAND SURVEY MONUMENT RECORD

(AS REQUIRED BY s.A-E 7.08, WI. ADM. CODE)

HISTORY OF ORIGINAL CORNER ESTABLISHMENT AND SUBSEQUENT RESTORATIONS AND DESCRIPTION OF ANY RECORD, MONUMENT, OCCUPATION, TESTIMONIAL OR OTHER EVIDENCE CONSIDERED

CORNER MONUMENT AND ALL TIES WERE DESTROYED IN THE AREA
RESTORED TO BRUCE BOWDEN LOCATION PER SKETCH BELOW.

COORDINATES ARE ESTABLISHED TO THE CORNER AND WITNESS TIES AS SHOWN BELOW

BEARING REFERENCE AND COORDINATES ARE GRANT COUNTY COORDINATE SYSTEM
NAD 83(91) ENGLISH SYSTEM

CORNER WAS: (CHECK ALL THAT APPLY)


- ☒ RESTORED THROUGH ACCEPTANCE OF AN OBLITERATED EVIDENCE LOCATION
- ☐ RESTORED THROUGH ACCEPTANCE OF A FOUND PERPETUATED LOCATION
CONSIDERED A LOST CORNER AND REESTABLISHED THROUGH LOST CORNER PROPORTIONATE METHODS
(INCLUDE A PLAN VIEW DRAWING SHOWING BEARING & DISTANCE TO OTHER PUBLIC LAND SURVEY CORNERS)
- ☐ USED FOR PROPORTIONING AND DETERMINING THE CORNER LOCATION
- ☐ RESTORED OR REESTABLISHED IN A LOCATION THAT DIFFERS FROM A PREVIOUS RESTORATION OR REESTABLISHMENT
(INCLUDE A PLAN VIEW DRAWING AND INDICATE WHAT WAS SET AND/OR FOUND)

Describe the monument and accessories used to perpetuate the location of the corner. (include a plan view drawing and indicated what was set and/or found)

LEGEND:

- ☒ SET 3/4" ϕ IRON PIPE
- ☐ FOUND STONE MONUMENT
- ☒ FOUND 6' TALL ANGLE IRON SET IN CONC.
- ☒ SET 7/8" X 24" REBAR
- () RECORDED AS
- ☒ SET "PK" NAIL
- x—x— FENCE
- ☒ FOUND 1" IRON PIPE

SECT 2 TOWN 6 N RANGE 1W	SECT 1 TOWN 6 N RANGE 1W
SECT 11 TOWN 6 N RANGE 1W	SECT 12 TOWN 6 N RANGE 1W

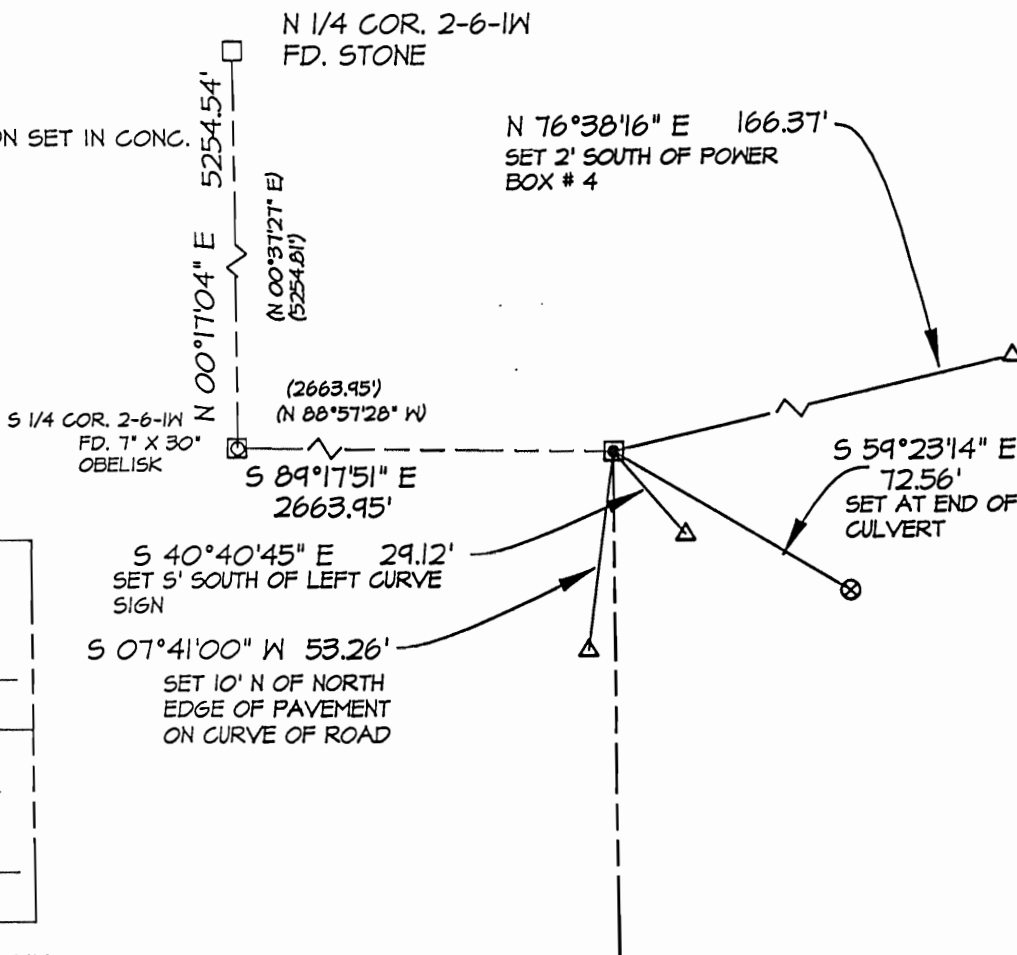

● = LOCATION OF CORNER

THE SE COR. OF SECT 2 T 6 N, R 1W

THE SW COR. OF SECT 1 T 6 N, R 1W

THE NW COR. OF SECT 12 T 6 N, R 1W

THE NE COR. OF SECT 11 T 6 N, R 1W

GRANT COUNTY, WISCONSIN

JOB ID: 085-084 BOOK #: 2008-3 P.56

I, LAURENCE E SCHMIT CERTIFY THAT THE CORNER LOCATION SHOWN ON THIS RECORD WAS DETERMINED BY ME OR UNDER MY DIRECTION AND CONTROL AND THAT THIS U.S. PUBLIC LAND SURVEY MONUMENT RECORD IS CORRECT AND COMPLETE TO THE BEST OF MY KNOWLEDGE AND BELIEF.

Laurence E Schmit

SIGNATURE

revised 5-19-09

DATE:

SCALE: 1" = 50'



LAND SURVEYORS SEAL

INDEX NUMBER 23


U. S. PUBLIC LAND SURVEY MONUMENT RECORD

INSTRUCTIONS:

APR 30 1991
This record shall show the location of the corner and shall include all of the following nine elements (a through i).

- (a) Identify the corner by reference to the U.S. public land survey system.

○ = Corner monument restored.

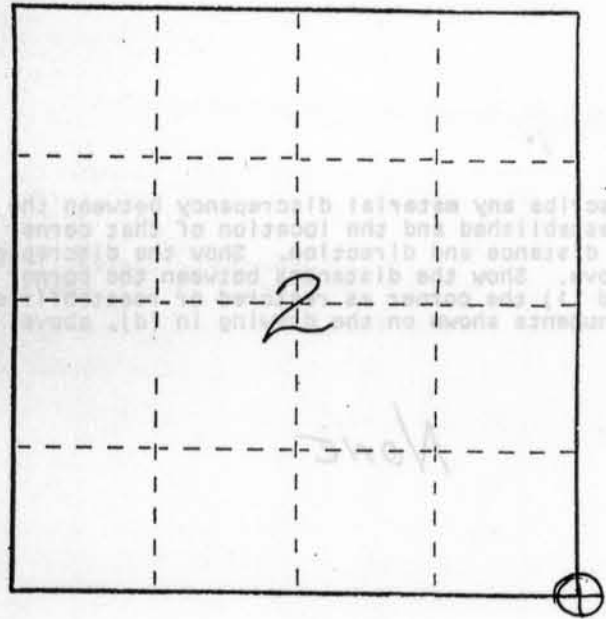


SOUTHEAST CORNER OF
SECTION 2, TOWN 6 NORTH,
RANGE 1 WEST, WINGVILLE
TOWNSHIP, GRANT COUNTY,
WISC.

- (b) Describe any record evidence, monument evidence, occupational evidence, testimonial evidence or any other material evidence you considered, and whether the monument was found or placed.

MONUMENT SET FROM EXISTING PHYSICAL EVIDENCE
OF FENCES AND ROADS, AFTER VERIFICATION BY
PROPORTIONATE MEASUREMENTS FROM AN EDM
TRAVERSE OF THE AREA.

- (c) In the plan view drawing below, provide reference ties to at least 4 witness monuments, or, if the location is within a municipality, to at least 2 witness monuments. (Witness monuments shall be made of concrete, natural stone, iron or other equally durable material, ~~except~~ wood.) Describe witness monuments.

- (d) Show a plan view drawing depicting the relevant monuments and reference ties which is sufficient in detail to enable accurate relocation of the corner monument if the corner monument is disturbed. Indicate north.

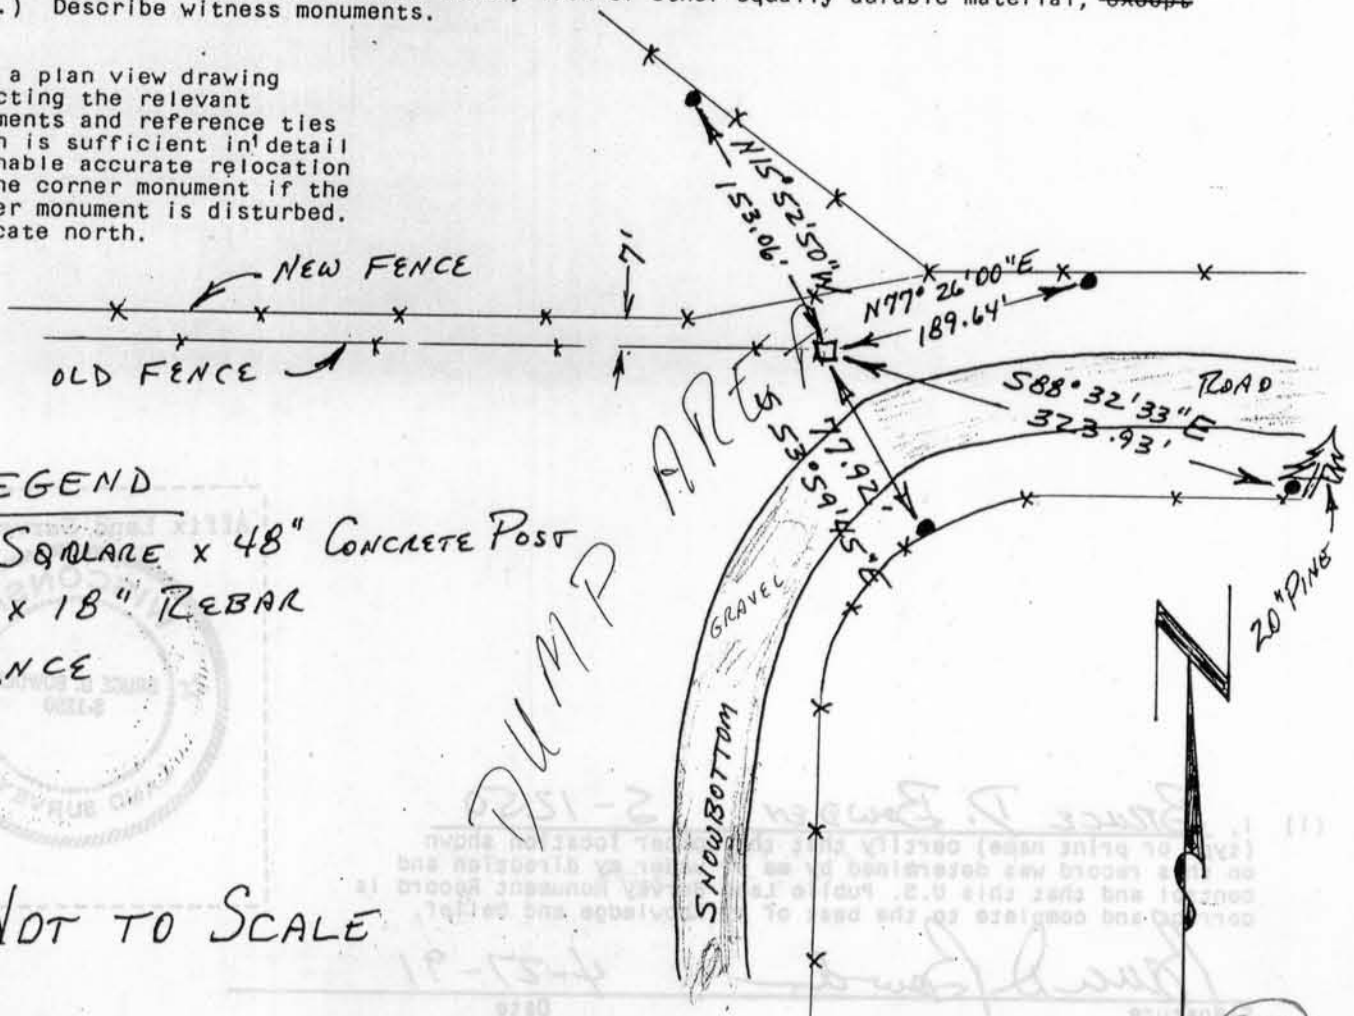

LEGEND

- 4" SQUARE x 48" CONCRETE POST
• #3 x 18" REBAR
*** FENCE

NOT TO SCALE

U. S. PUBLIC LAND SURVEY MONUMENT RECORD

APR 30 1991

This record shall show the location of the corner and shall include all of the following nine elements (a through i).

(a) Identify the corner by reference to the U.S. Public Land Survey System.
(b) Corner monument restored.

- (e) Describe any material discrepancy between the location of the corner as restored or reestablished and the location of that corner as previously restored or reestablished by distance and direction. Show the discrepancy on the plan view drawing under (d), above. Show the distances between the corner as previously restored or reestablished and (1) the corner as restored or reestablished, and (2) to at least 2 of the witness monuments shown on the drawing in (d), above.

NONE

- (f) Was the corner restored through acceptance of (1) an obliterated evidence location, or, (2) a found perpetuated location?

(2) A FOUND PERPETUATED LOCATION

- (g&h) Was the corner reestablished through lost corner proportionate methods? If so, show the method, including the directions and distances to other public land survey corners used as evidence or used for proportioning in determining the corner location?

No.

Affix Land Surveyor Seal



(i) I, Bruce D. Bowden S-1250

(type or print name) certify that the corner location shown on this record was determined by me or under my direction and control and that this U.S. Public Land Survey Monument Record is correct and complete to the best of my knowledge and belief.

Signature

Date

4-27-91