




U.S. PUBLIC LAND SURVEY MONUMENT RECORD - GRANT COUNTY, WI
 Summary of Section 8, Town 6 North Range 1 West, Town of Wingville

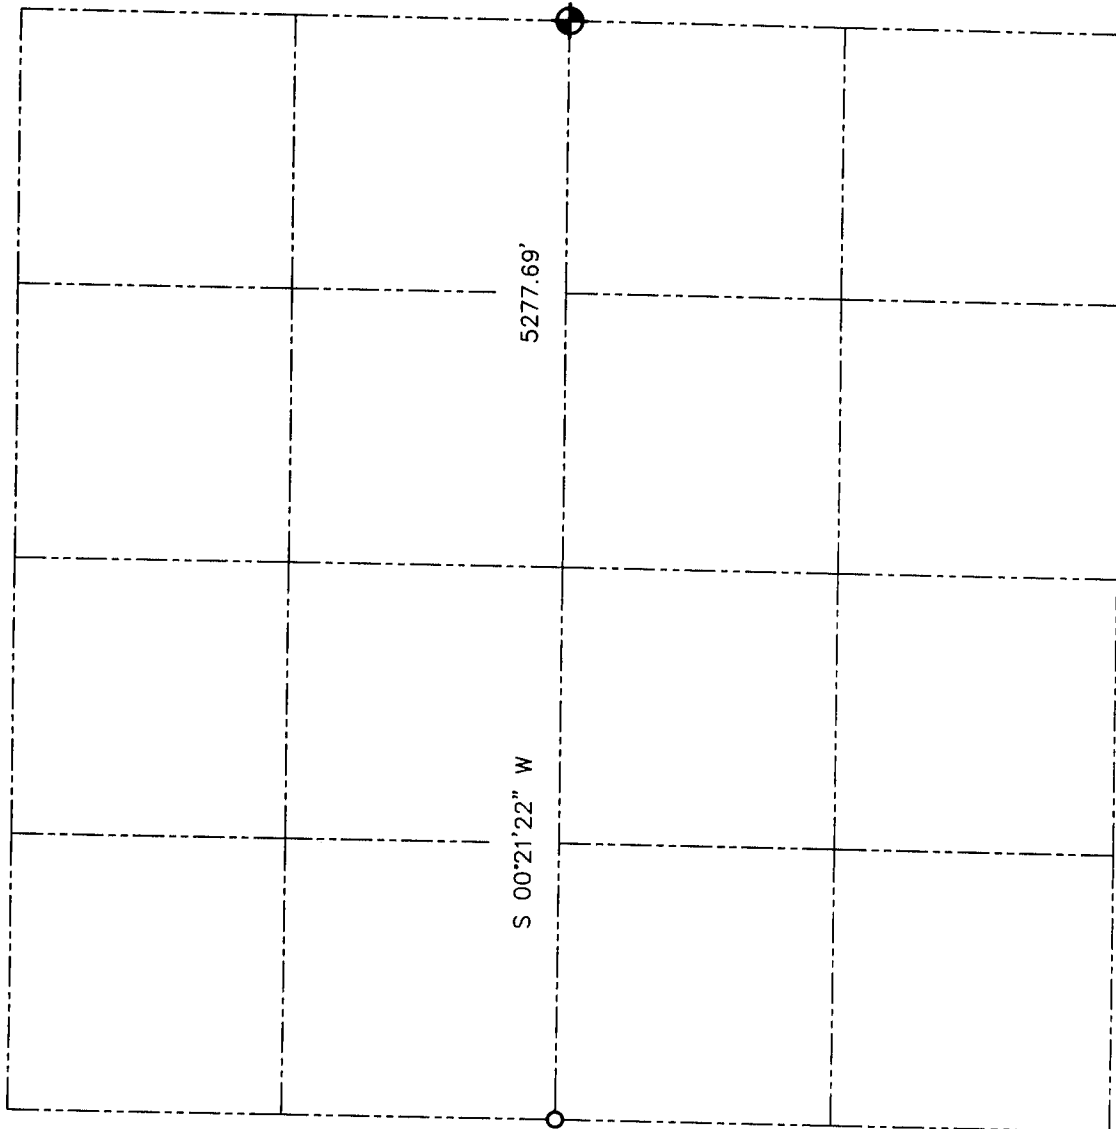

LEGEND

-  NUMBER 8 x 30" REBAR SET WITH GRANT COUNTY ALUMINUM CAP
-  NUMBER 6 REBAR FOUND



Relationship of all section corners to other section corners shall be shown hereon by bearing and distance or grid coordinates. Bearing reference shown below.



Dated this 14th day of December, 2001

Larry L. Austin
 Larry L. Austin S-1903

Bearings referenced to the North-South Quarter line of Section 8, which is assumed to bear S 00°21'22" W.

SKETCH NOT TO SCALE

AUSTIN ENGINEERING, LLC

4211 HWY 81 EAST, LANCASTER, WI 53813
 PHONE 608-723-6363 FAX 608-723-6702

FIELDBOOK: SDR33, 21-35
 G:\T7NR2W\33
 C:\SWA\TIE\T7NR2W\08SUM

CREW: BS-SB-SA-BD
 DRAWN BY: SW AUSTIN
 APPROVED: LL AUSTIN