
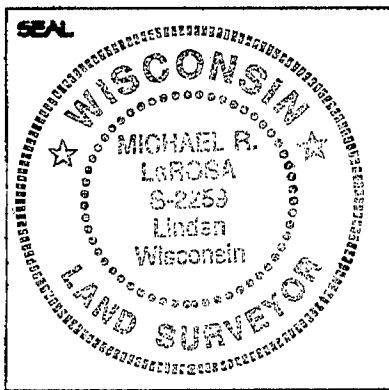


SECTION SUMMARY SHEET

SECTION 15 T6N R/W

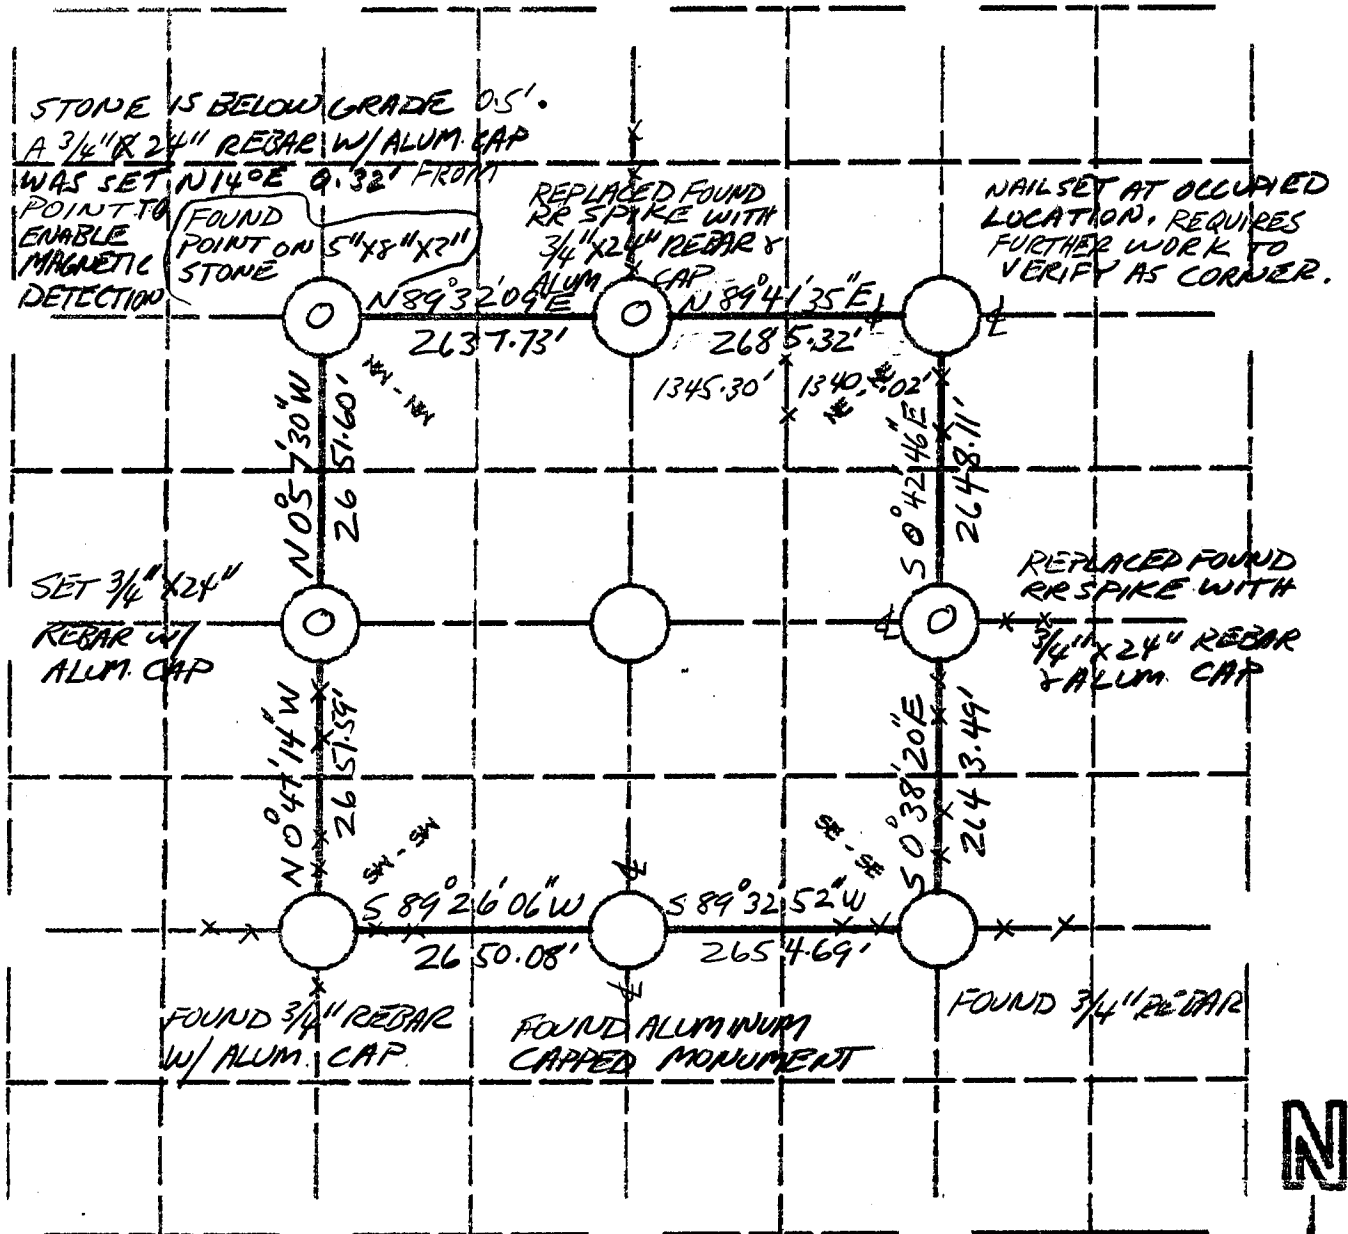

LEGEND:

- COUNTY MONUMENT SET
- △ COUNTY MONUMENT FOUND
- OTHER(Specify)
- *** OTHER(Specify) FENCE
- ⊕ OTHER(Specify) ROAD CENTERLINE
- OTHER(Specify)

Horiz. Datum	<input type="checkbox"/> NAD 27
	<input type="checkbox"/> NAD 83(91)
Units	<input type="checkbox"/> ENGLISH
	<input type="checkbox"/> Metric
Co-ordinate System	<input type="checkbox"/> Geodetic
	<input type="checkbox"/> State Plane(S. zone)
	<input type="checkbox"/> Lat. County

The information provided in this box is not req'd, but requested to be provided if available to the surveyor preparing this sheet; otherwise provide reference in accordance with survey plat related to preparation of this sheet.

Place coordinates furnished adjacent to the corner(s) on section sketch above.

Michael R. Lrosca 10/19/1999

SIGNATURE

DATE