

# U.S. PUBLIC LAND SURVEY MONUMENT RECORD - GRANT COUNTY, WI

Section 2, Town 6 North Range 2 West, Town of Fennimore (a)



NOTE: This form is intended and designed to fulfill all requirements of the Wisconsin Administrative Code Chapter A-E 7.08, U.S. Public Land Survey Monument Record (3) (a) (b) (c) (d) (e) (f) (g) (h) (i).

**CERTIFICATE:** (i)

I, Aaron J. Austin, Wisconsin Professional Land Surveyor, do hereby certify that the corner location on this record was determined by me and/or under my direct supervision and that this U.S. Public Land Survey Monument Record is correct and complete to the best of my knowledge and belief.

Dated this 1st day of November, 2021.

*Aaron J. Austin*  
Aaron J. Austin, S-2922

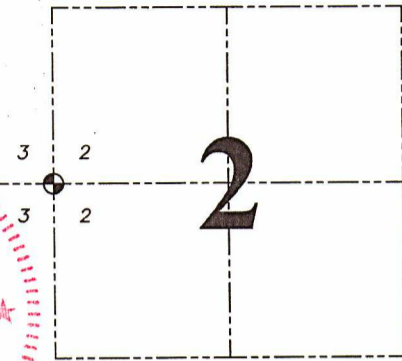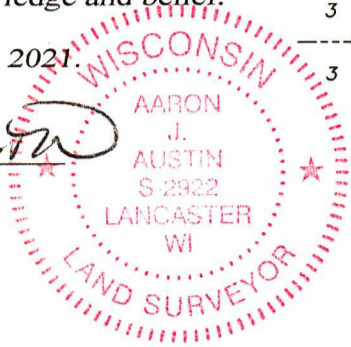

● = CORNER LOCATION

Grant County Coordinates:  
NAD 83 (2011)  
Northing: 588,055.60  
Easting: 852,099.08

HISTORY OF CORNER ESTABLISHMENT:

Original corner was set in 1833 by Harvey Parke.  
Larry Austin set a 1" Rebar with a Grant County Aluminum Cap and prepared a Survey Monument Record dated 5/1/2008.

DESCRIPTION OF CORNER EVIDENCE FOUND: (b) (f) (g) (h)

I found four witness corners Larry set. I set a 1 1/4" x 24" Rebar using the existing witness corners. I verified the Monument's location with G.P.S. and E.D.M. methods.

DESCRIPTION OF CORNER AND WITNESS MONUMENTS, references and accessories used to perpetuate the original or re-established location of this corner. (c) (d) (e)

Witnesses to corner location Shane Austin.  
Drawn by Owen Austin

SKETCH:

## LEGEND

- Section Corner—as designated
- 1/2" rebar found
- ⊙ Existing stump
- x-x-x- Existing fence
- ( ) Recorded as
- ⊙ Existing tree



W O O D S

W O O D S

