

# U.S. PUBLIC LAND SURVEY MONUMENT RECORD - GRANT COUNTY, WI

Section 7, Town 6 North Range 2 West, Town of Fennimore (a)



NOTE: This form is intended and designed to fulfill all requirements of the Wisconsin Administrative Code Chapter A-E 7.08, U.S. Public Land Survey Monument Record (3) (a) (b) (c) (d) (e) (f) (g) (h) (i).

### CERTIFICATE: (i)

I, Aaron J. Austin, Wisconsin Professional Land Surveyor, do hereby certify that the corner location on this record was determined by me and/or under my direct supervision and that this U.S. Public Land Survey Monument Record is correct and complete to the best of my knowledge and belief.

Dated this 3rd day of August, 2020.

*Aaron J. Austin*  
Aaron J. Austin, S-2922

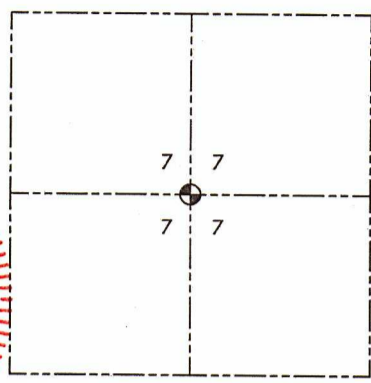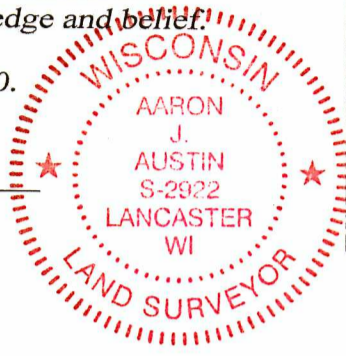

⊕ = CORNER LOCATION

Grant County Coordinates:  
NAD 83 (2011)  
Northing: 582,807.87  
Easting: 833,583.99

### HISTORY OF CORNER ESTABLISHMENT:

Original corner was never set with the Government Survey.  
Bruce Bowden set a 3/4" rebar on a Survey in Book 15, Page 35 dated 6/14/2004.


### DESCRIPTION OF CORNER EVIDENCE FOUND: (b) (f) (g) (h)

I found the 3/4" rebar Bowden set. I set four witness corners after I verified the Monument's location with G.P.S. and E.D.M. methods.

### DESCRIPTION OF CORNER AND WITNESS MONUMENTS, references and accessories used to perpetuate the original or re-established location of this corner. (c) (d) (e)

Witnesses to corner location Shane Austin.  
Drawn by Owen Austin

### SKETCH:

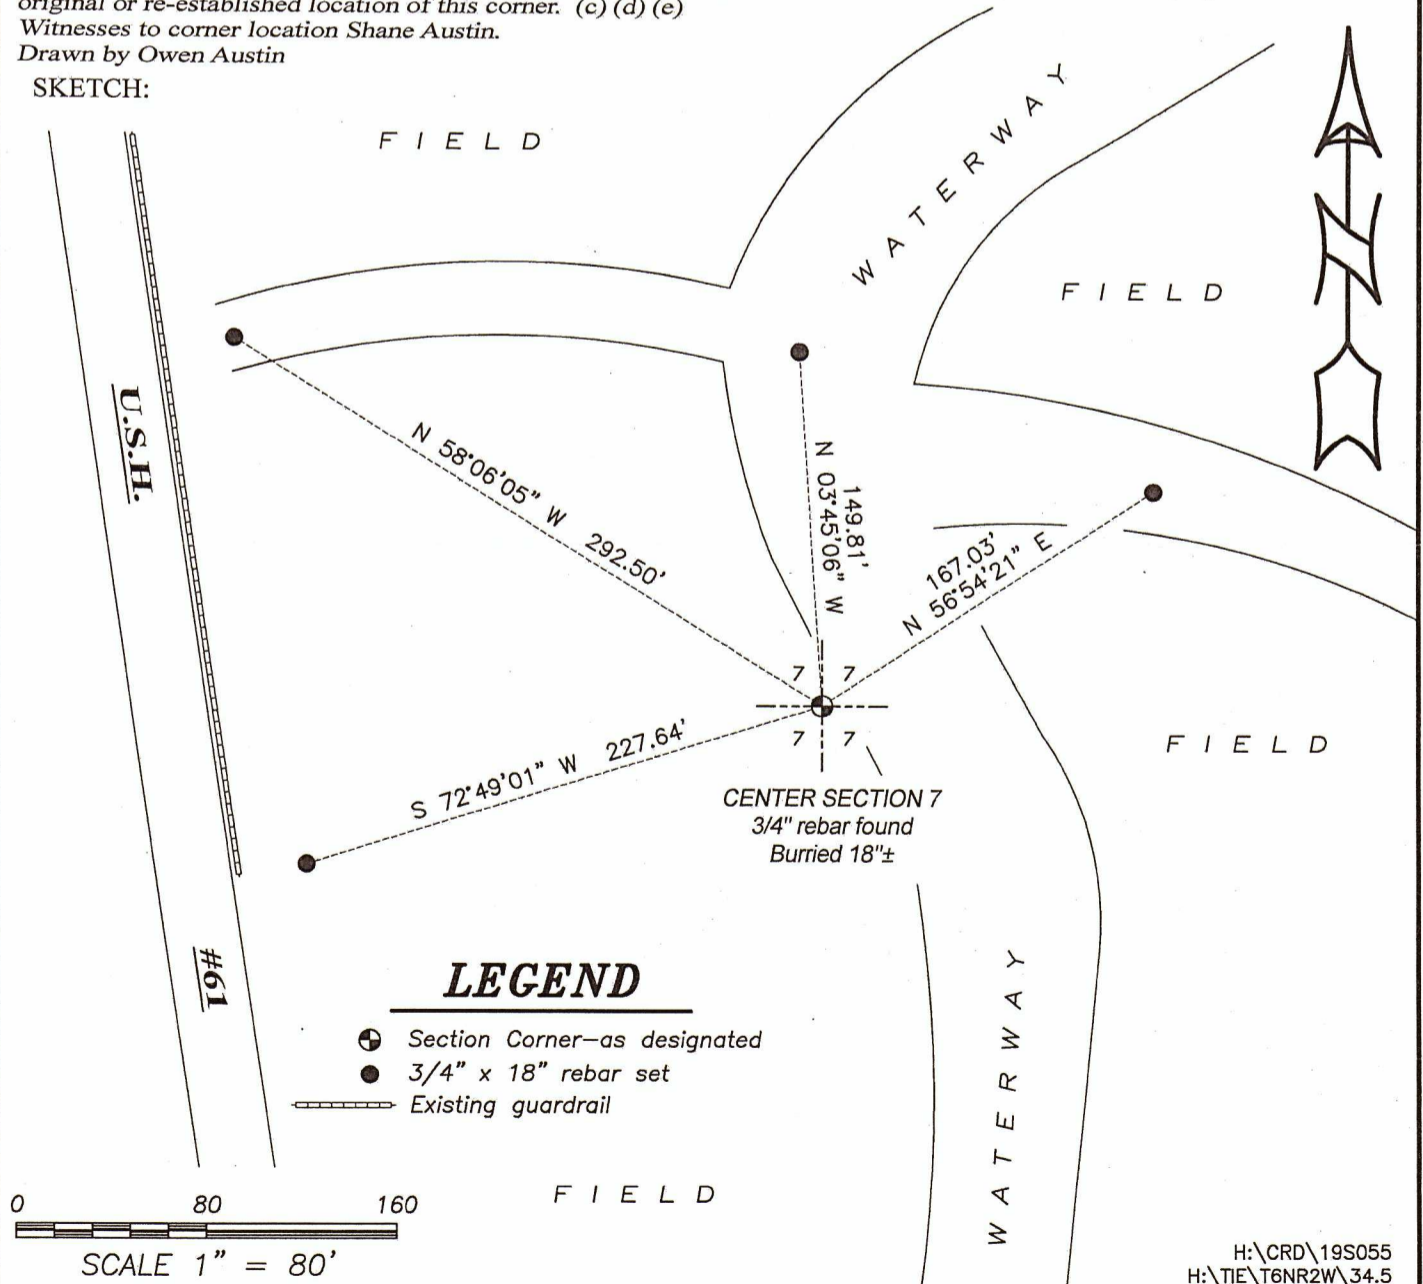

### LEGEND

- ⊕ Section Corner—as designated
- 3/4" x 18" rebar set
- Existing guardrail

