


**U.S. PUBLIC LAND SURVEY MONUMENT RECORD – GRANT COUNTY, WI**  
**Section 30, Town 6 North Range 2 West, Town of Fennimore**

CERTIFICATE

I, Larry L. Austin, do hereby certify that the corner location on this record was determined by me and/or under my direct supervision and that this U.S. public land survey monument record is correct and complete to the best of my knowledge and belief.

Dated this 5th day of February, 1996

*Larry L. Austin*  
 Larry L. Austin  
 LAND SURVEYOR  
 AUSTIN  
 LANCASTER  
 WI  
 1905

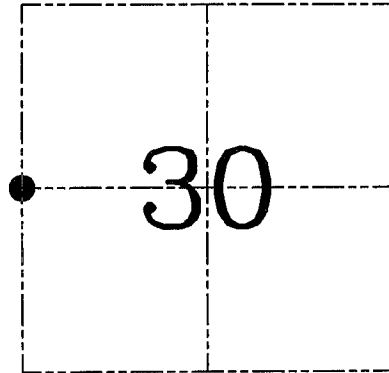

● = CORNER LOCATION

HISTORY OF CORNER ESTABLISHMENT


Corner was never originally set.  
 No recent record of the corner was found.

DESCRIPTION OF CORNER EVIDENCE FOUND

I reset the corner proportionately and on-line between the Northwest and Southwest corners of Section 30. This location matched the occupation really well. Verified this location using EDM & GPS methods.

DESCRIPTION OF CORNER AND WITNESS MONUMENTS, references and accessories used to perpetuate the original or re-established location of this corner. Witnesses to corner location Bobby Sedgwick & Dan Ketchum

**SKETCH:**

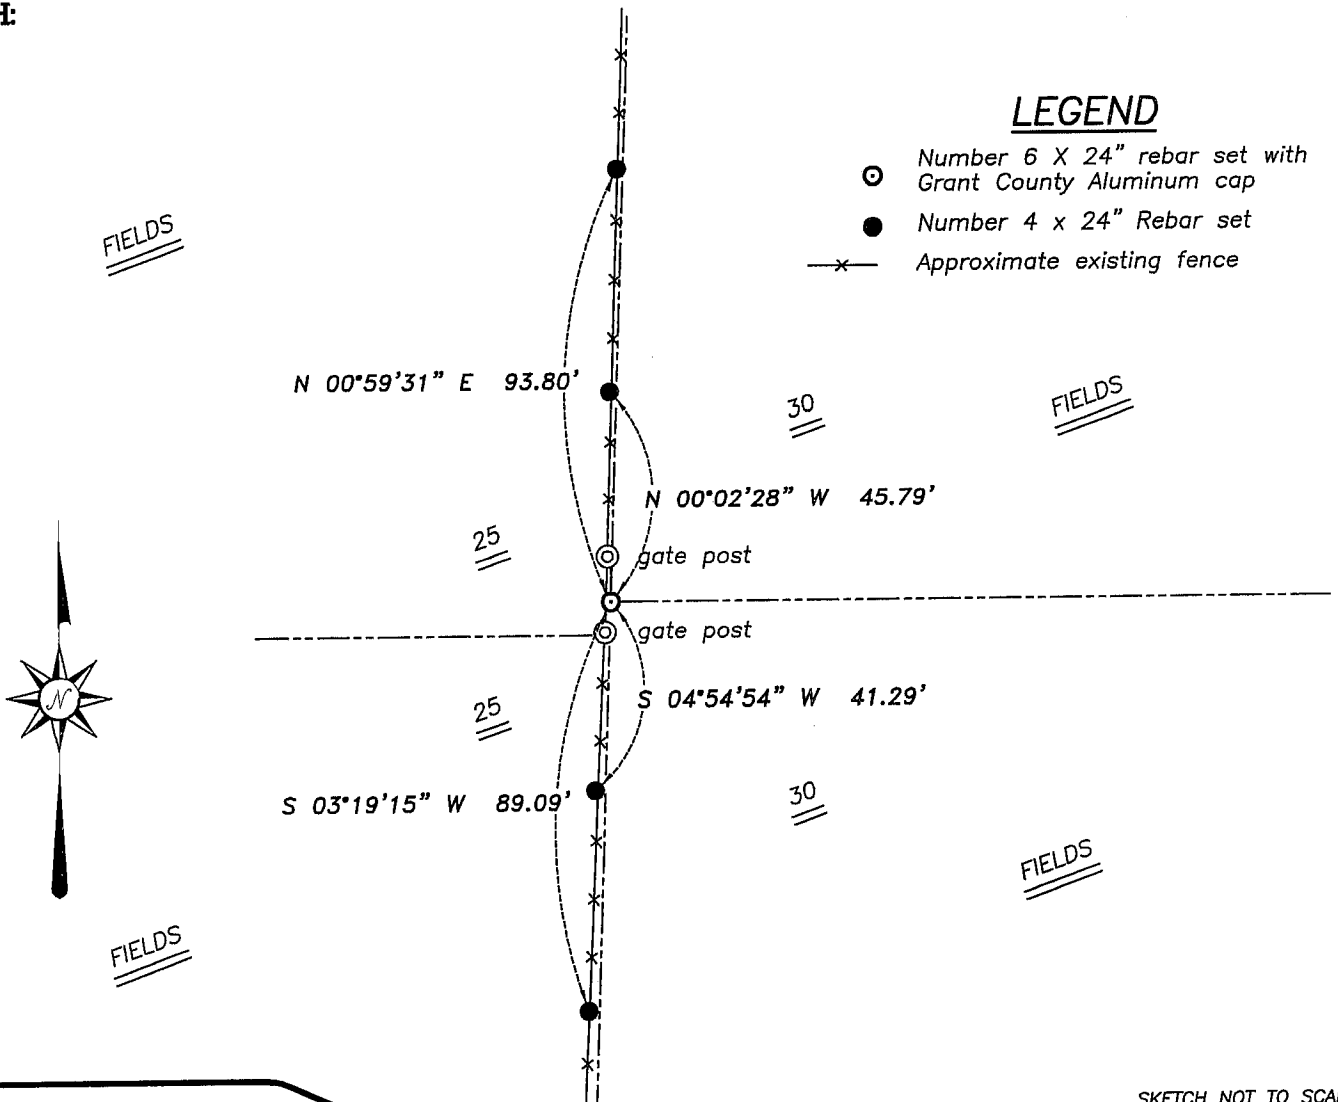

SKETCH NOT TO SCALE



**Austin Engineering LLC**

4211 HWY 81 E, LANCASTER, WI 53813  
 PHONE 608-723-6363 FAX 608-723-6702

JOB NUMBER NA  
 FIELDBOOK: 95-18  
 G:\T6NR2W\30  
 H:\TIE\T6NR2W\94

DRAWN BY: SW AUSTIN  
 APPROVED: LL AUSTIN