

U.S. PUBLIC LAND SURVEY MONUMENT RECORD - GRANT COUNTY, WI

Section 35, Town 6 North Range 2 West, Town of Fennimore (a)


NOTE: This form is intended and designed to fulfill all requirements of the Wisconsin Administrative Code Chapter A-E 7.08, U.S. Public Land Survey Monument Record (3) (a) (b) (c) (d) (e) (f) (g) (h) (i).

CERTIFICATE: (i)

I, Aaron J. Austin, Wisconsin Professional Land Surveyor, do hereby certify that the corner location on this record was determined by me and/or under my direct supervision and that this U.S. Public Land Survey Monument Record is correct and complete to the best of my knowledge and belief.

Dated this 4th day of March, 2026.

Aaron J. Austin
Aaron J. Austin, PLS-2922

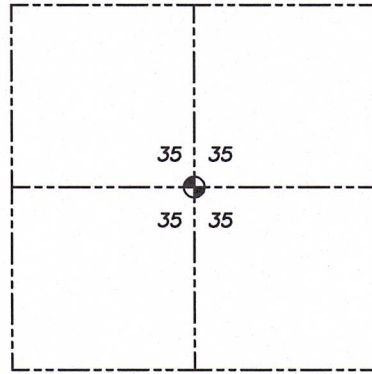

⊕ = CORNER LOCATION

Grant County Coordinates:
NAD 83 (2011)
Northing: 561,585.75
Easting: 854,959.48

HISTORY OF CORNER ESTABLISHMENT:

Corner was not set with the Original Government Survey.
Larry Austin set a 3/4" Rebar on a Survey filed in Book 22, Page 28 dated 1-4-2008.
Larry Austin found a 3/4" Rebar on C.S.M. #1460 dated 12-18-2008.
Keith Dalsing found a 3/4" Rebar on a Survey filed in Book 31 Page 20 dated 4-30-2012.
Keith Dalsing found a 3/4" Rebar on a Survey filed in Book 33 Page 75 dated 5-1-2013.
I found a 3/4" Rebar on a Survey filed in Book 47, Page 27 dated 8-12-2021.
I found a 3/4" Rebar on a Survey filed in Book 54 Page 82 dated 6-1-2021.

DESCRIPTION OF CORNER EVIDENCE FOUND: (b) (f) (g) (h)

I found the 3/4" Rebar Larry set. I set four witness corners and verified the Monument's location with G.P.S. methods.

DESCRIPTION OF CORNER AND WITNESS MONUMENTS, references and accessories used to perpetuate the original or re-established location of this corner. (c) (d) (e)

Witnesses to corner location Owen Austin, Tanner Austin.
Drawn by: Owen Austin.

SKETCH:

LEGEND

- ⊕ Section Corner—as designated
- 3/4" x 18" rebar set
- x-x-x- Existing fence

