



SECTION SUMMARY SHEET

SECTION 15 T 6N R 2W

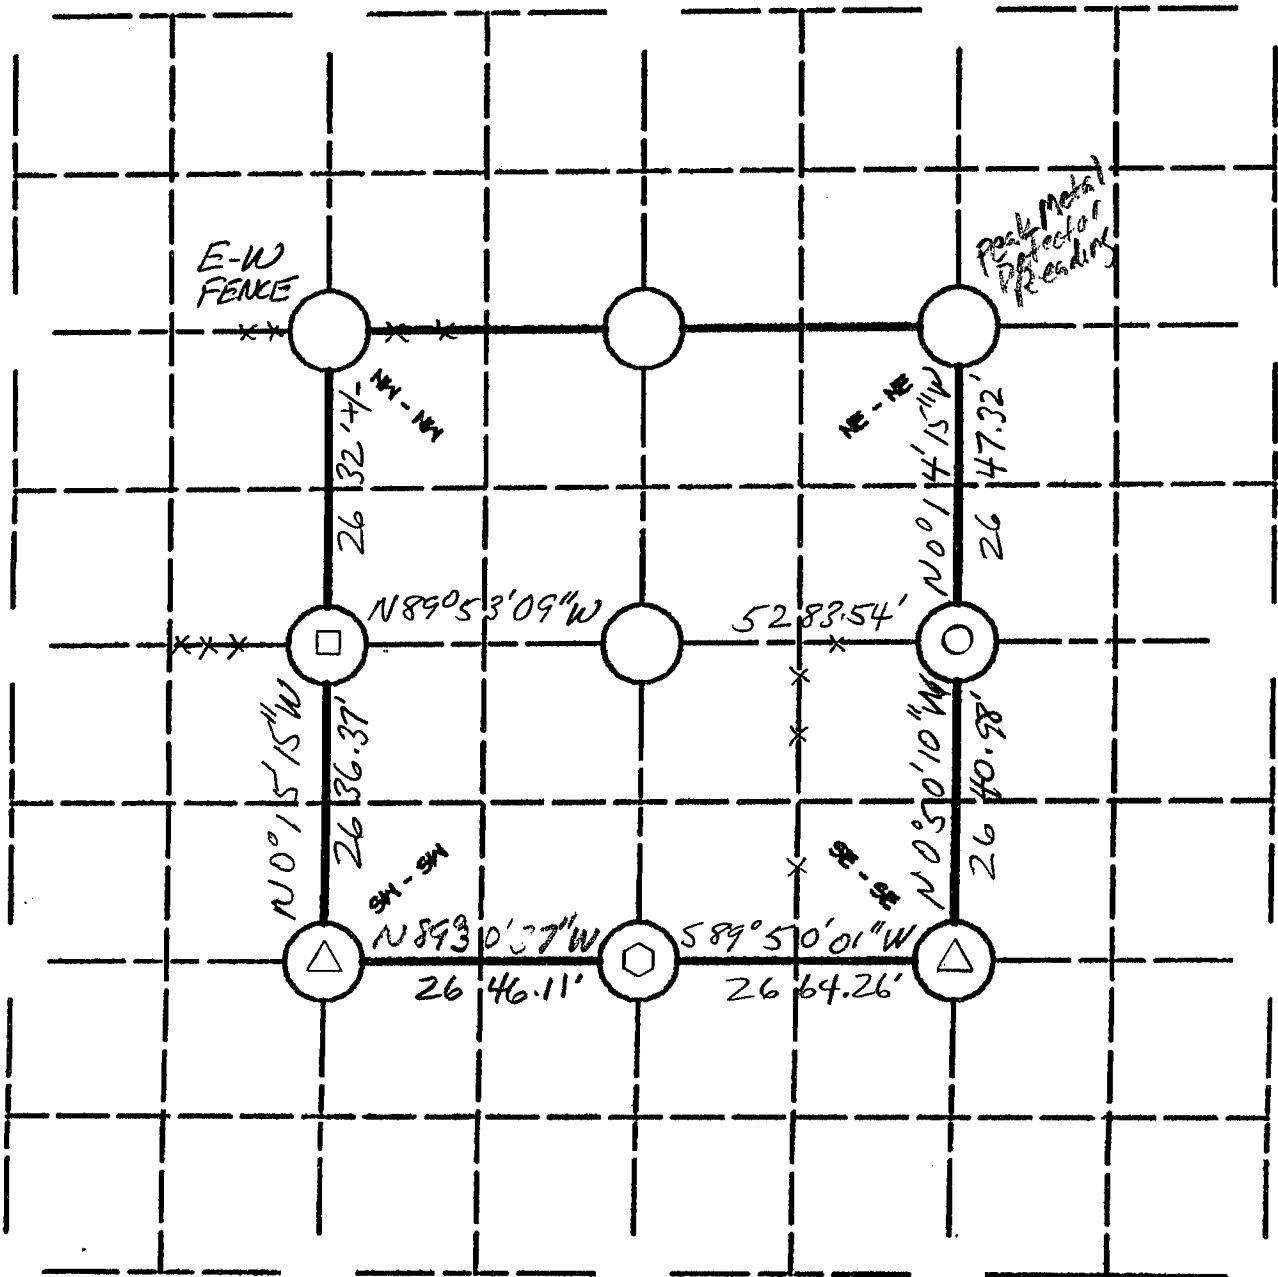

Grant Co. Coord. Sys. **N**

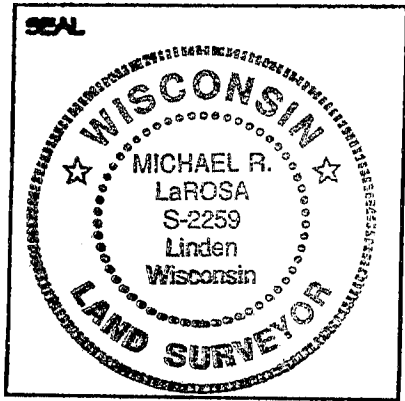

LEGEND:

- COUNTY MONUMENT SET
- COUNTY MONUMENT FOUND
- OTHER(Specify)
- OTHER(Specify) CORNER IN CREEK - SET REFERENCE MONUMENTS
- OTHER(Specify)
- OTHER(Specify) 4" CONCRETE FILLED PIPE FOUND

BEARINGS REF.

section sheets for coordinates

Michael R. LaRosa
7/28/2005

SIGNATURE DATE

<p>Horiz. Datum</p> <input type="checkbox"/> NAD 27 <input type="checkbox"/> NAD 83(11) <p>Units</p> <input type="checkbox"/> ENGLISH <input type="checkbox"/> Metric <p>Co-ordinate System</p> <input type="checkbox"/> Geodetic <input type="checkbox"/> State Plane(S. zone) <input type="checkbox"/> Lat. County	<p>The information provided in this box is not req'd, but requested to be provided if available to the surveyor preparing this sheet; otherwise provide reference in accordance with survey plat related to preparation of this sheet.</p> <p>Place coordinates furnished adjacent to the corner(s) on section sketch above.</p>
--	--