





**U.S. PUBLIC LAND SURVEY MONUMENT RECORD - GRANT COUNTY, WI**  
 Summary of Section 34, Town 6 North Range 2 West, Town of Fennimore

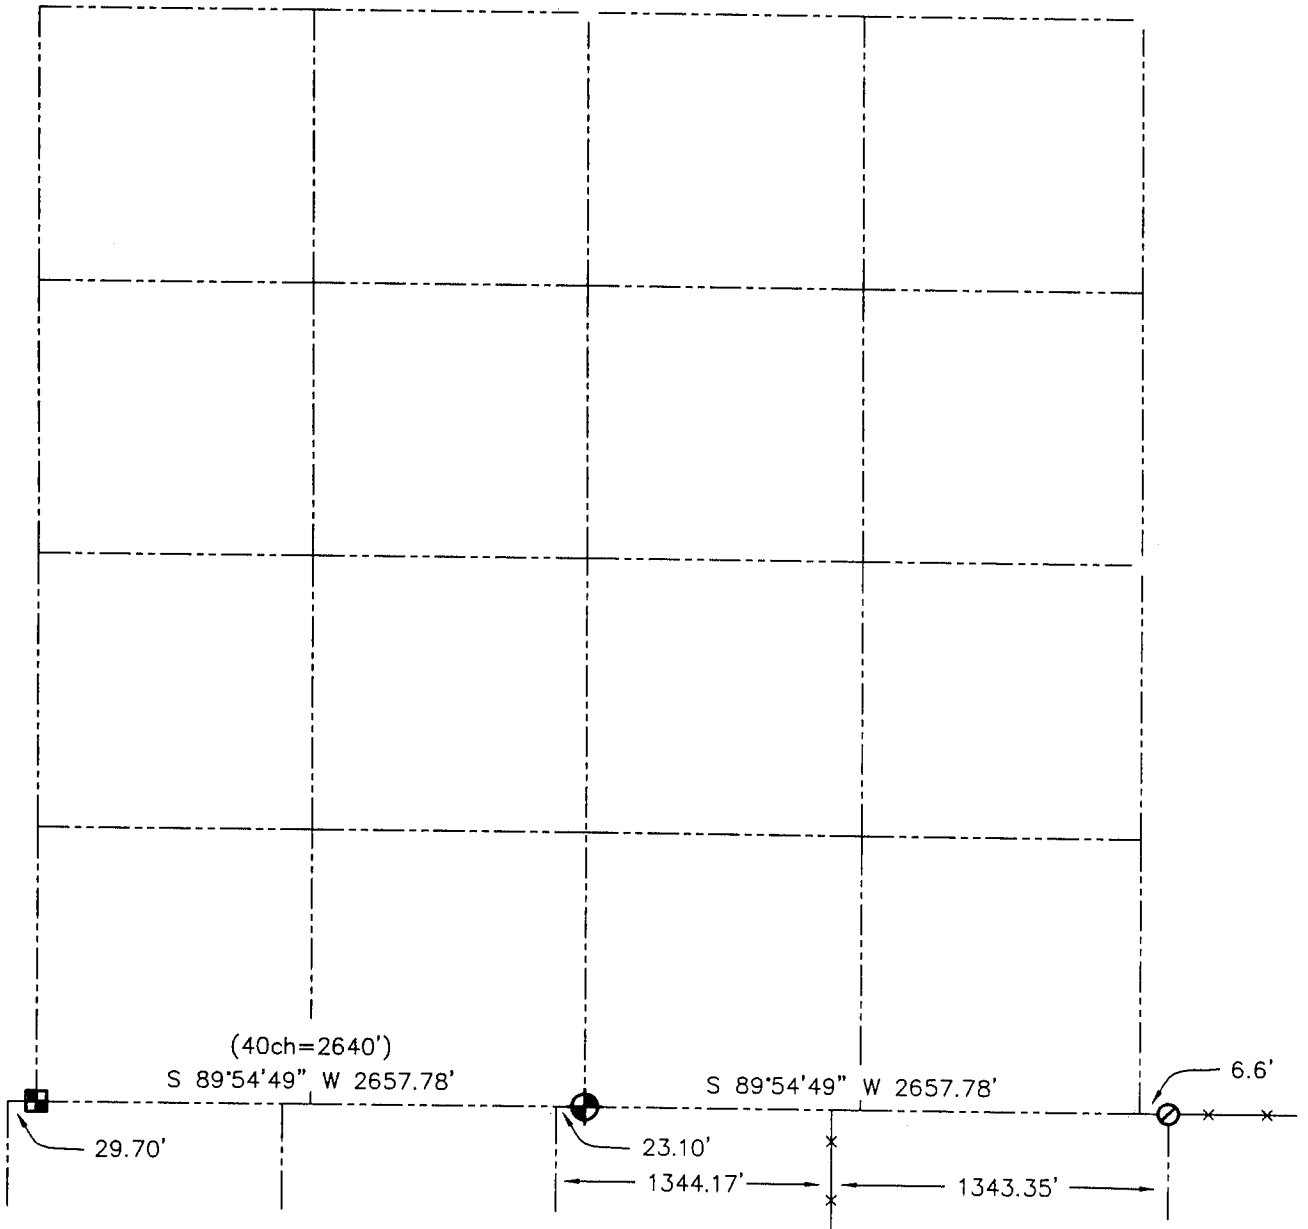

**LEGEND**

-  NUMBER 8 x 30" REBAR SET WITH GRANT COUNTY ALUMINUM CAP
-  P.K. NAIL FOUND
-  ALUMINUM MONUMENT FOUND WITH GRANT COUNTY ALUMINUM CAP
- ( ) RECORDED AS



Relationship of all section corners to other section corners shall be shown hereon by bearing and distance or grid coordinates. Bearing reference shown below.

Dated this 12th day of December, 2001

Austin, WI 53603

Bearings referenced to the South line of the Southwest Quarter of Section 34, which is assumed to bear S 89°54'49" W.

SKETCH NOT TO SCALE

**AUSTIN ENGINEERING, LLC**  
 4211 HWY 81 EAST, LANCASTER, WI 53813  
 PHONE 608-723-6363 FAX 608-723-6702

FIELDBOOK: SDR33  
 G: \T6NR2W\34  
 C: \SWA\TIE\T6NR2W\34SUM

CREW: BS-SB-SA-DM  
 DRAWN BY: SW AUSTIN  
 APPROVED: LL AUSTIN