

# U.S. PUBLIC LAND SURVEY MONUMENT RECORD - GRANT COUNTY, WI

Section 2, Town 6 North Range 3 West, Town of Mount Ida (a)


NOTE: This form is intended and designed to fulfill all requirements of the Wisconsin Administrative Code Chapter A-E 7.08, U.S. Public Land Survey Monument Record (3) (a) (b) (c) (d) (e) (f) (g) (h) (i).

**CERTIFICATE: (i)**

I, Aaron J. Austin, Wisconsin Professional Land Surveyor, do hereby certify that the corner location on this record was determined by me and/or under my direct supervision and that this U.S. Public Land Survey Monument Record is correct and complete to the best of my knowledge and belief.

Dated this 22nd day of February, 2019

*Aaron J. Austin*  
Aaron J. Austin, S-2922

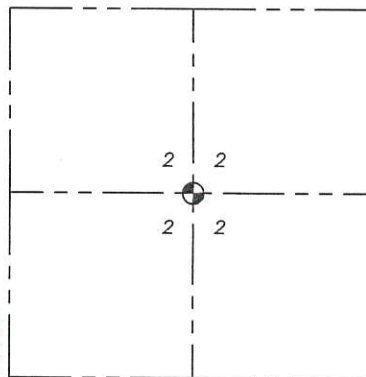

⊕ = CORNER LOCATION

Grant County Coordinates:  
NAD 83 (2011)  
Northing: 588,059.67  
Easting: 822,918.14

HISTORY OF CORNER ESTABLISHMENT:

Corner was not set with Original Government Survey. I found a 3/4" rebar and accepted it as the corner on a Survey with a revised dated of 1-31-2011 filed in Book 28, Page 84. I measured to the corner on a Survey dated 5-12-2017 filed in Book 40, Page 26.

DESCRIPTION OF CORNER EVIDENCE FOUND: (b) (f) (g) (h)

I set four witness corners after I verified the monument's location with G.P.S. and E.D.M. methods

DESCRIPTION OF CORNER AND WITNESS MONUMENTS: references and accessories used to perpetuate the original or re-established location of this corner. (c) (d) (e)

Witnesses to corner location Shane Austin, Owen Austin.

SKETCH:

## LEGEND

- ⊕ Section Corner—as designated
- 3/4" rebar found
- 3/4" x 18" rebar set
- ☉ Existing tree
- x-x- Existing fence

