

U.S. PUBLIC LAND SURVEY MONUMENT RECORD - GRANT COUNTY, WI

Section 15, Town 6 North Range 3 West, Town of Mount Ida (a)


NOTE: This form is intended and designed to fulfill all requirements of the Wisconsin Administrative Code Chapter A-E 7.08, U.S. Public Land Survey Monument Record (3) (a) (b) (c) (d) (e) (f) (g) (h) (i).

CERTIFICATE: (i)

I, Aaron J. Austin, Wisconsin Professional Land Surveyor, do hereby certify that the corner location on this record was determined by me and/or under my direct supervision and that this U.S. Public Land Survey Monument Record is correct and complete to the best of my knowledge and belief.

Dated this 31st day of January, 2023.

Aaron J. Austin
Aaron J. Austin, S-2922

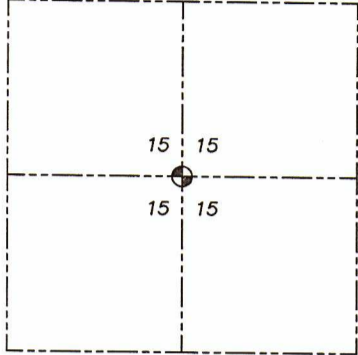

● = CORNER LOCATION

Grant County Coordinates:
NAD 83 (2011)
Northing: 577,442.81
Easting: 817,651.54

HISTORY OF CORNER ESTABLISHMENT:

Corner was not set with the Original Government Survey.
Larry Austin set a 1" Iron Pipe on a Survey dated 5/22/1992 filed in Book 27, Page 36.
Larry Austin tied to the corner on a Survey dated 4/10/1998 filed in Book 2, Page 57.

DESCRIPTION OF CORNER EVIDENCE FOUND: (b) (f) (g) (h)

I found and did not accept a 3/4" Rebar at a fence corner. I found and accepted the 1" Iron Pipe set by Larry Austin. I set four witness corner after I verified the Monument's location with G.P.S. and E.D.M. methods.

DESCRIPTION OF CORNER AND WITNESS MONUMENTS, references and accessories used to perpetuate the original or re-established location of this corner. (c) (d) (e)

Witnesses to corner location Owen Austin, Tanner Austin.
Drawn by: Owen Austin

SKETCH:

LEGEND

- Section Corner—as designated
- 3/4" rebar found
- 3/4" x 18" rebar set
- x-x-x- Existing fence
- ~~~~~ Edge of field

