



PLAT OF SURVEY


LOCATED IN T6N R3W, MOUNT IDA
TOWNSHIP, GRANT COUNTY, WISCONSIN

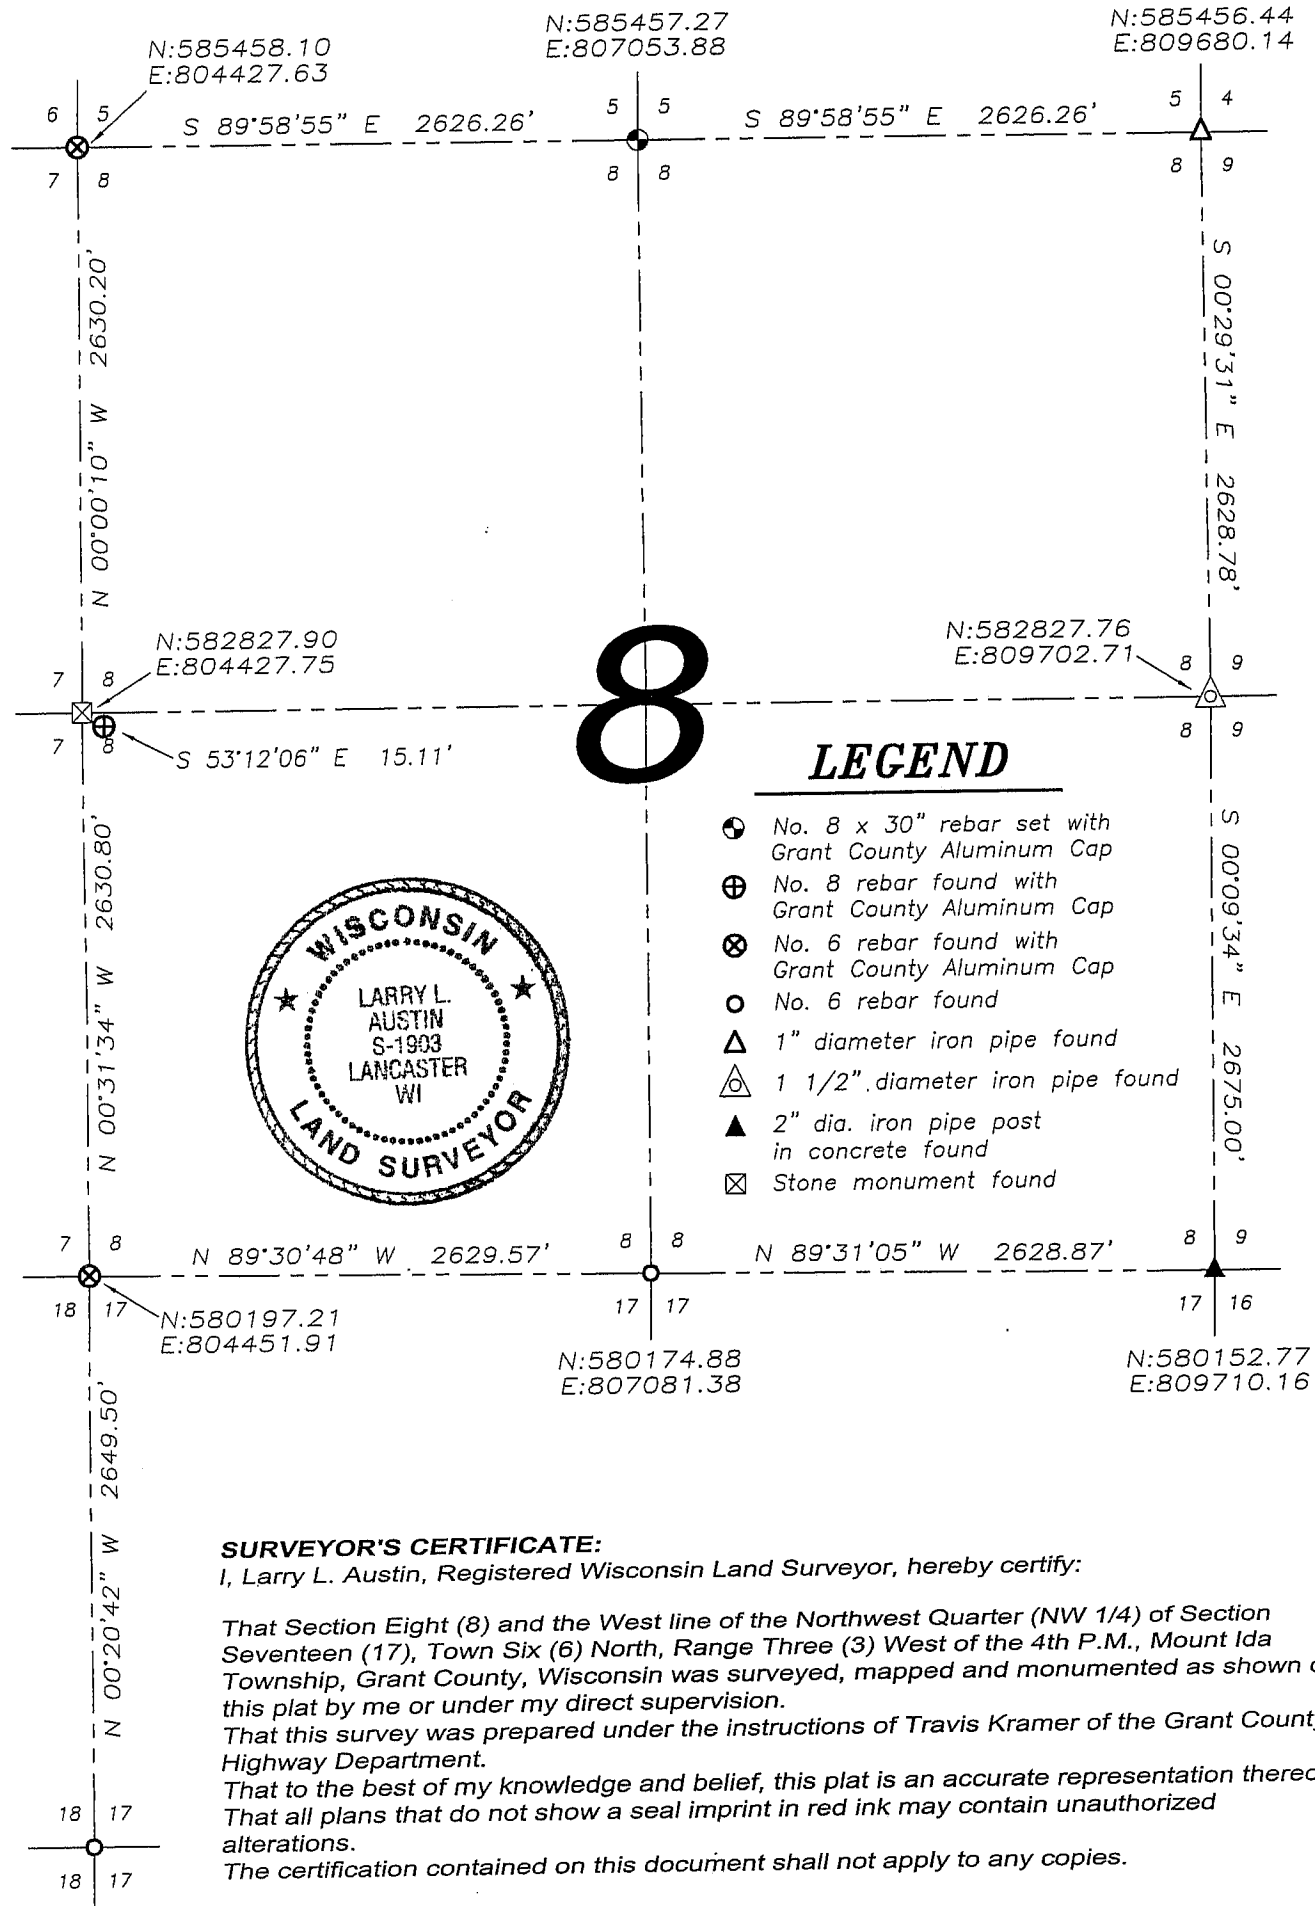

Bearings are referenced to the Grant County Coordinate System.

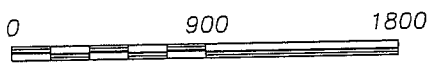

SCALE 1" = 900'

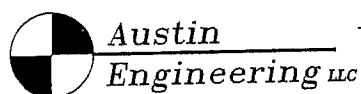

4211 HWY 81 E, LANCASTER, WI 53813
PHONE 608-723-6363 FAX 608-723-6702

Prepared For: GRANT COUNTY HIGHWAY DEPT.

JOB NO: 08s259
FIELDBOOK: TDSR
G:\T6NR3W\08
H:\PLAT\T6NR3W\08\08s259-GCHD

DRAWN BY: AJ AUSTIN
APPROVED: LL AUSTIN
CREW: BS-SA-SB-BD-BH

SHEET 1 OF 1