

GRANT COUNTY

Survey Monument Record

TYPE OF MONUMENT COUNTY MONUMENT

STATE PLANE COORDINATES: N _____
E _____

ELEVATION — M.S.L. DATUM: _____

THETA ANGLE: _____

FIELD BOOK: 95-06

PAGE 13


CORNER NO. 39

SECTION 12

TOWN 6N

RANGE 4W

W 1/4 COR.

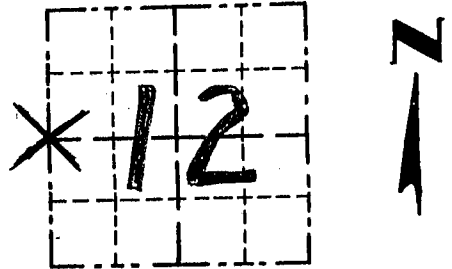

LOCATION
(Indicated by "X")


BASIS FOR MONUMENT LOCATION

(Use reverse side if necessary)

Show info such as: History of corner, with reference to Vol. and pg., dates, surveyor; exact description of monument replaced; if location computed, by taped or EDM traverse; landowner, remarks, etc.

SEAL:

CORNER ORIGINALLY SET IN 1833 BY PARKE; NO RECORD FOUND OF CORNER SINCE THEN; I ACCEPTED N-S FENCE LINE FOR E-W LOCATION & PROPORTIONED ITS N-S LOCATION TO THE W 1/4 CORNER OF SEC 1 & TO THE SW CORNER OF SEC. 12; VERIFIED THE LOCATION BY EDM TRAVERSE OF THE AREA.

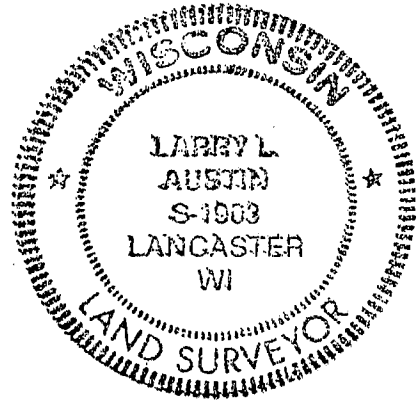

CERTIFIED CORRECT

Larry L. Austin
Registered Land Surveyor
DATE: 4/20/95

TIE SKETCH

Show at least three (3) ties and monument

