

GRANT COUNTY

Survey Monument Record

TYPE OF MONUMENT 1 1/2" IRON PIPE FOUND
 STATE PLANE COORDINATES: N _____
 E _____
 ELEVATION — M.S.L. DATUM: _____
 THETA ANGLE: _____
 FIELD BOOK: 9506
 PAGE 14


CORNER NO. 40
 SECTION 12
 TOWN 6 N
 RANGE 4 W
E 1/4 COR.

BASIS FOR MONUMENT LOCATION

(Use reverse side if necessary)


Show info such as: History of corner, with reference to Vol. and pg., dates, surveyor; exact description of monument replaced; if location computed, by taped or EDM traverse; landowner, remarks, etc.

CORNER ORIGINALLY SET BY SIBLEY IN 1832; I ACCEPTED OCCUPATIONAL EVIDENCE AT THE CORNER LOCATION & VERIFIED BY EDM TRAVERSE OF THE AREA.

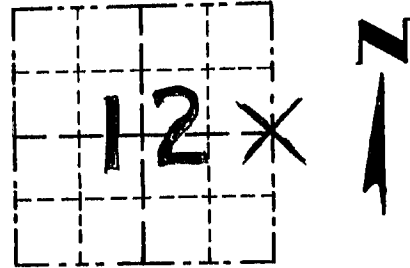

LOCATION
(Indicated by "X")

SEAL:

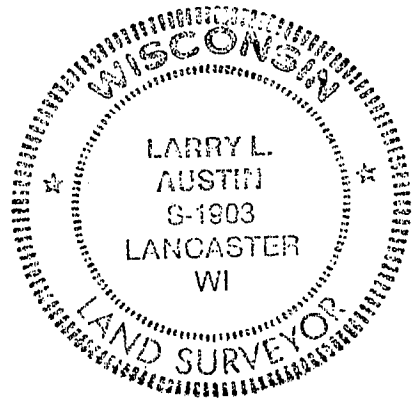

CERTIFIED CORRECT

Larry L. Austin
 Registered Land Surveyor

DATE: 4/20/95

TIE SKETCH

Show at least three (3) ties and monument

