

Mt. Hope Twp.

GRANT COUNTY Government Land Corner Certificate

TYPE OF MONUMENT: LARGE STONE ELEVATION — M.S.L. DATUM: _____
STATE PLANE COORDINATES: N _____ THETA ANGLE: _____
Wis. South Zone E _____ FIELD BOOK: GRANT-1 PAGE 11


Basis for Monument Location

(Use reverse side if necessary.
Show info such as: History of corner, with reference to Vol. and page, dates, surveyor; exact description of monument found; if location computed, by taped or EDM traverse; landowner remarks, witnesses, etc.)

Located a stone monument at the corner described hereon. This stone has been used in previous surveys as recent as 1981.

I accepted this stone as the true corner.

RECEIVED

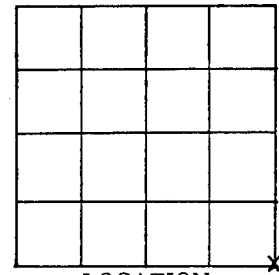

LOCATION
(Indicated by 'X')


~~CITY, VILLAGE~~ or TOWN MT. HOPE
SECTION 17
TOWN 6 N
RANGE 4 W
DRAFTED BY SMW
FIELD CREW MATTHEW J. JANIAK
SEAN WALSH

SEP 9 1985

TIE SKETCH

(Show at least four ties. Also, fence lines, C of roads, and any other helpful factors and features.)

● - 3/4" iron rod placed.

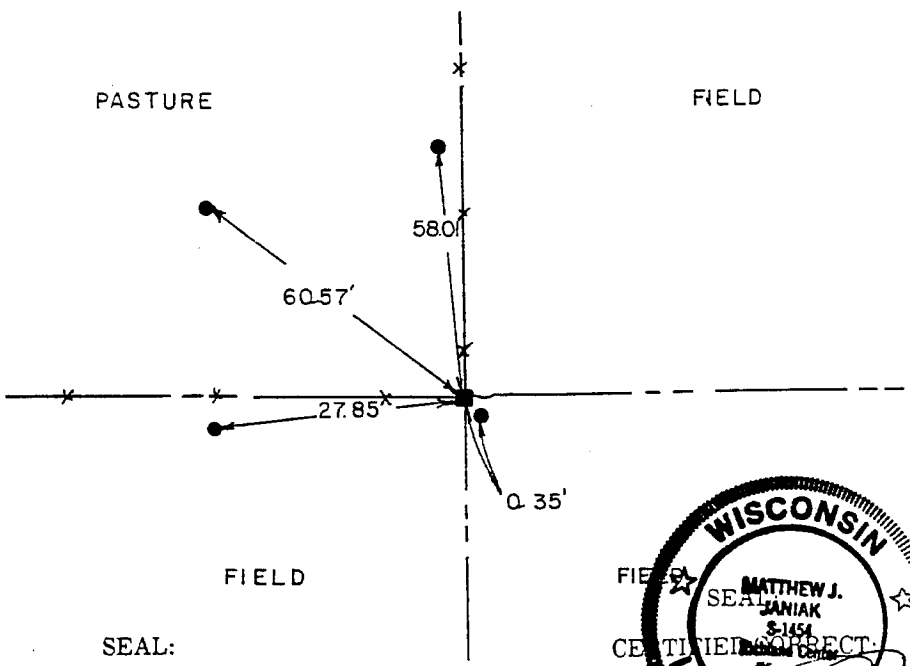

| CORNER MAINTENANCE INFO | SEAL: |
|-------------------------|-------|
| | |
| | |
WISCONSIN
MATTHEW J. JANIAK
SEAL
S-1451
REGISTERED LAND SURVEYOR
DATE: 9-5-85

269