

U.S. PUBLIC LAND SURVEY MONUMENT RECORD – GRANT COUNTY, WI


Section 36, Town 6 North Range 4 West, Town of Mount Hope

CERTIFICATE

I, Larry L. Austin, do hereby certify that the corner location on this record was determined by me and/or under my direct supervision and that this U.S. public land survey monument record is correct and complete to the best of my knowledge and belief.

Dated this 21st day of March, 2003

Larry L. Austin
Larry L. Austin S-1903

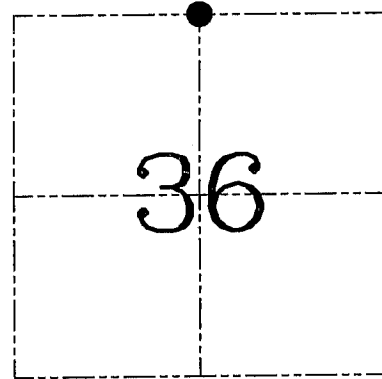

● = CORNER LOCATION

HISTORY OF CORNER ESTABLISHMENT

Corner was originally set in 1833 by Parke.
No other record of the corner was found.


DESCRIPTION OF CORNER EVIDENCE FOUND

I reset the corner proportionately between the monumented Northwest and Northeast corners of Section 36. Verified this location using EDM & GPS methods.

DESCRIPTION OF CORNER AND WITNESS MONUMENTS, references and accessories used to perpetuate the original or re-established location of this corner. Witnesses to corner location Bobby Sedgwick & Shelby Blindert & Brad Digman

SKETCH:

LEGEND

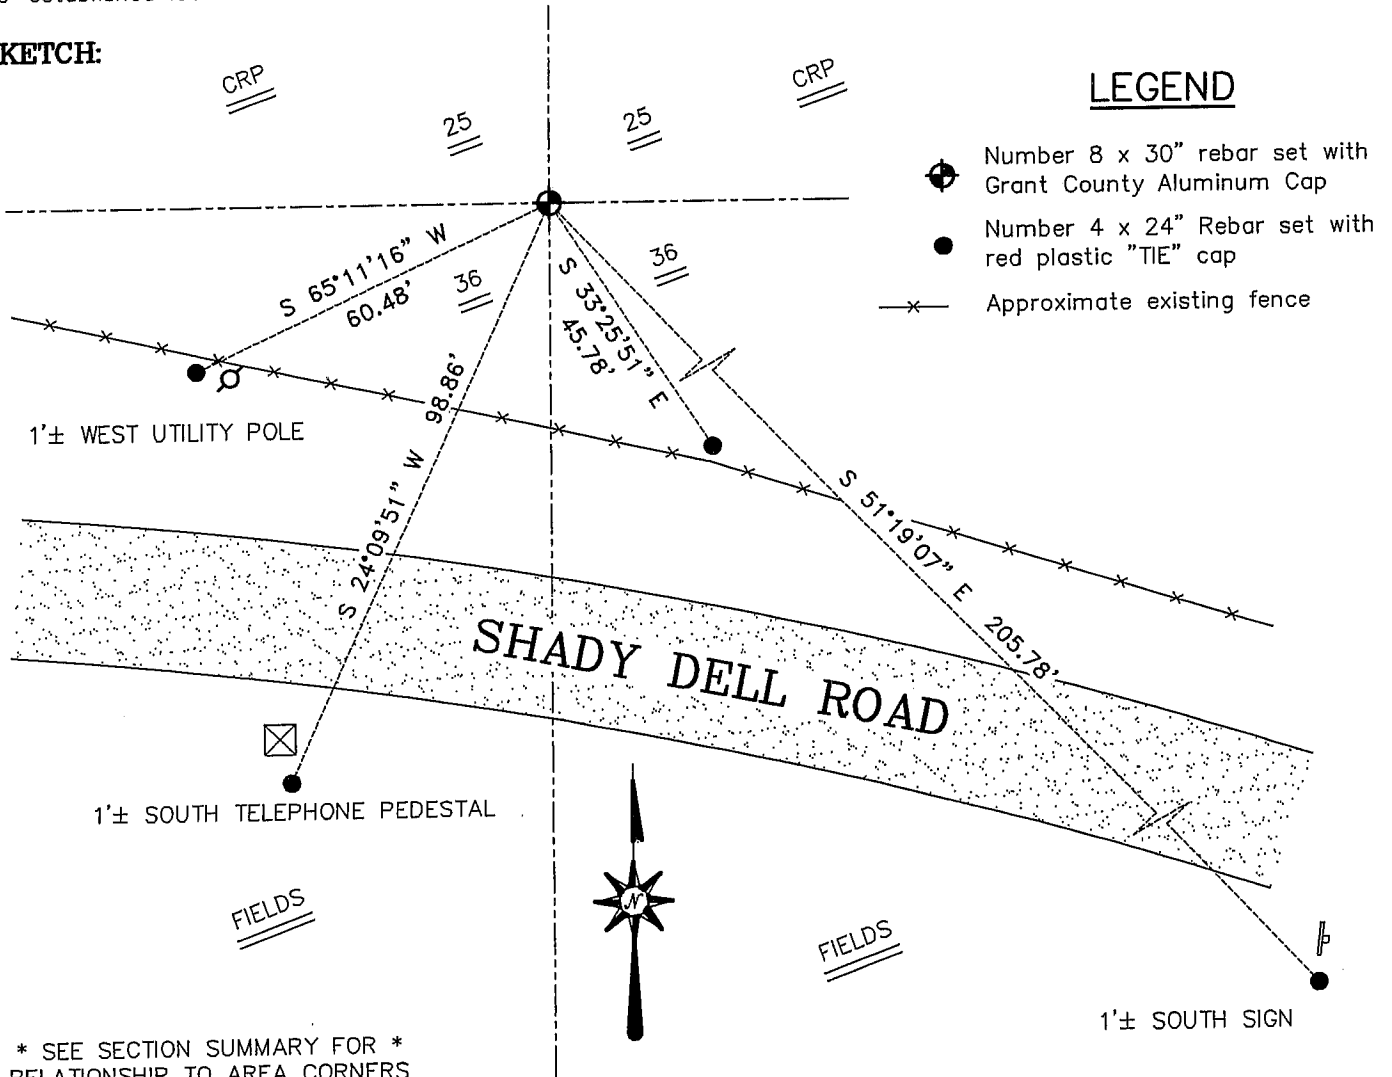

* SEE SECTION SUMMARY FOR *
RELATIONSHIP TO AREA CORNERS

SKETCH NOT TO SCALE

AUSTIN ENGINEERING, LLC

4211 HWY 81 EAST, LANCASTER, WI 53813
PHONE 608-723-6363 FAX 608-723-6702

FIELDBOOK: SDR33, 23-01
G: \T5NR4W\02
C: \SWA\TIE\T6NR4W\102
JOB NUMBER 03S013

DRAWN BY: SW AUSTIN
APPROVED: LL AUSTIN

CORNER NUMBER 102