

64107

U.S. PUBLIC LAND SURVEY MONUMENT RECORD - GRANT COUNTY, WI

Section 33, Town 6 North Range 4 West, Town of Mount Hope (a)



NOTE: This form is intended and designed to fulfill all requirements of the Wisconsin Administrative Code Chapter A-E 7.08, U.S. Public Land Survey Monument Record (3) (a) (b) (c) (d) (e) (f) (g) (h) (i).

CERTIFICATE: (i)

I, Aaron J. Austin, Wisconsin Professional Land Surveyor, do hereby certify that the corner location on this record was determined by me and/or under my direct supervision and that this U.S. Public Land Survey Monument Record is correct and complete to the best of my knowledge and belief.

Dated this 20th day of October, 2022.

Aaron J. Austin
Aaron J. Austin, S-2922

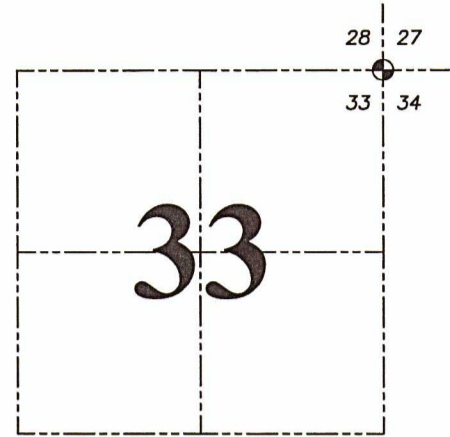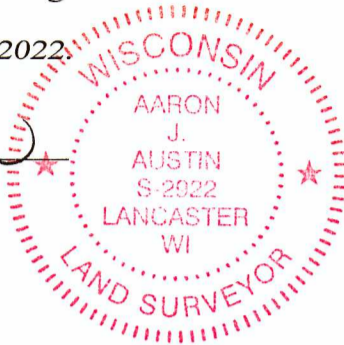

⊕ = CORNER LOCATION

Grant County Coordinates:
NAD 83 (2011)
Northing: 564,332.32
Easting: 783,204.72

HISTORY OF CORNER ESTABLISHMENT:

Original corner was set in 1833 by Harvey Parke.
John Halverson set a 1 1/4" Rebar and prepared a Survey Monument Record dated 11/13/1992.

DESCRIPTION OF CORNER EVIDENCE FOUND: (b) (f) (g) (h)

I found the 1 1/4" Rebar and two witness corners Halverson set. I set two additional witness corners after I verified the Monument's location with G.P.S. and E.D.M. methods.

DESCRIPTION OF CORNER AND WITNESS MONUMENTS, references and accessories used to perpetuate the original or re-established location of this corner. (c) (d) (e)

Witnesses to corner location Owen Austin.
Drawn by: Owen Austin


SKETCH:

LEGEND

- ⊕ Section Corner—as designated
- 5/8" rebar found
- 5/8" x 18" rebar set
- x-x-x- Existing fence
- ~~~~~ Edge of field
- () Recorded as

P A S T U R E


P A S T U R E

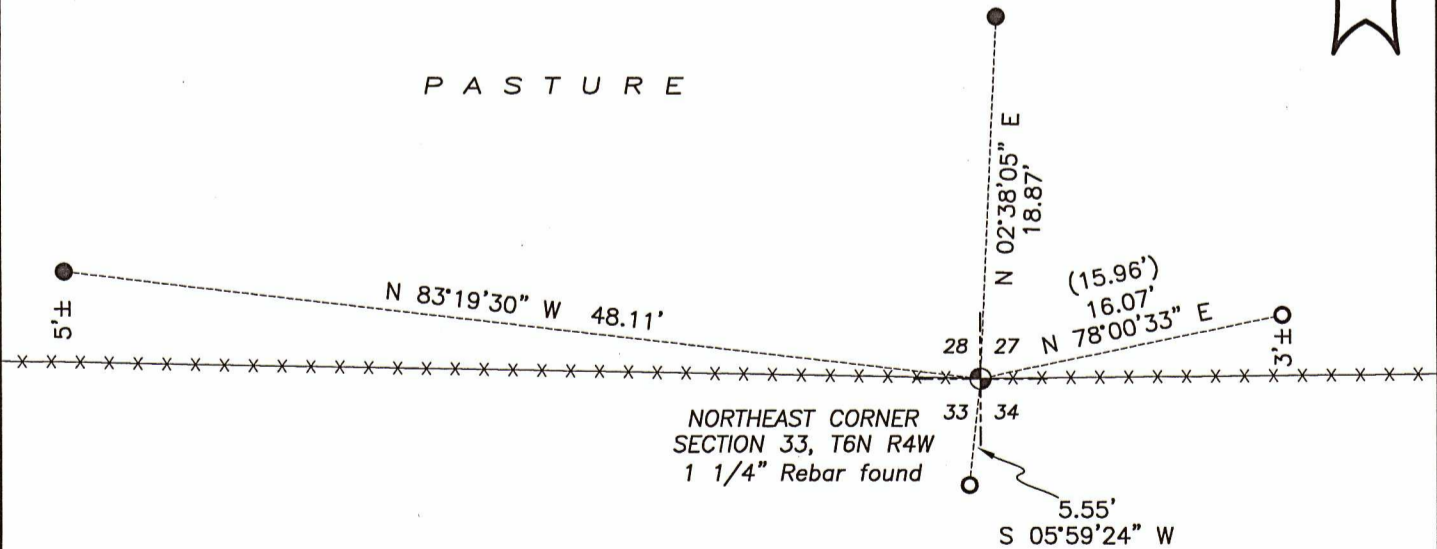

NORTHEAST CORNER
SECTION 33, T6N R4W
1 1/4" Rebar found

F I E L D

F I E L D

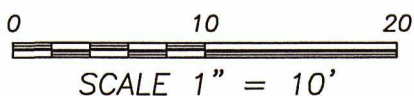

SEP 17 1993

U. S. PUBLIC LAND SURVEY MONUMENT RECORD


I N S T R U C T I O N S : This record shall show the location of the corner and shall include all of the following nine elements (a through i).

(a) Identify the corner by reference to the U.S. public land survey system.

○ = Corner monument restored.

Southwest corner of Section 27,
Town 6 North, Range 4 West, Town of
Mount Hope, Grant County, WI

Set 1 1/4" x 30" Iron Rod

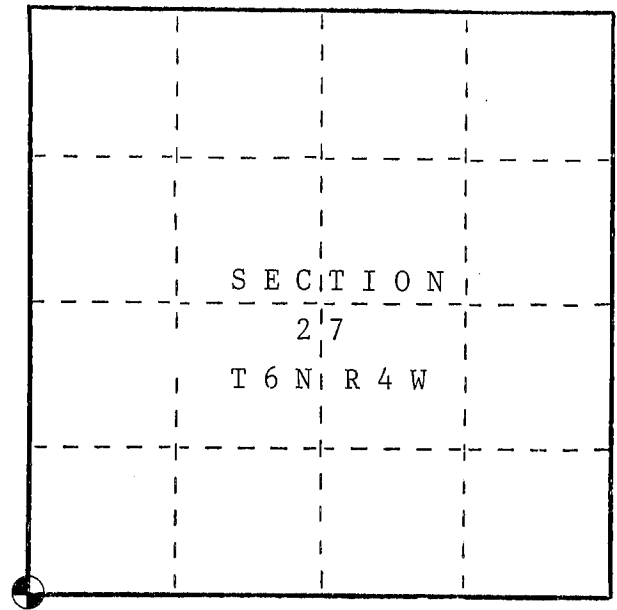


(b) Describe any record evidence, monument evidence, occupational evidence, testimonial evidence or any other material evidence you considered, and whether the monument was found or placed. Volume C, Page 121, Grant County Survey records-Survey dated September 23, 1854 in Section 33 located this corner. Volume C, Page 122, Grant County Survey records-Survey located this corner. Survey dated September 23, 1854.

Volume C, Page 120, Grant County Survey records-Survey of Section 28 located this corner and referenced two bearing trees. Survey dated September 22, 1854.

There is no evidence of the bearing trees per the above survey. Mr. Ferguson, the adjacent landowner has lived here for 70 years and states that there was a 3 way occupation corner at an existing old set post. This corner fit very well with surrounding occupation lines. I set this corner at the base of the set post per Mr. Ferguson's testimony.

(c) In the plan view drawing below, provide reference ties to at least 4 witness monuments, or, if the location is within a municipality, to at least 2 witness monuments. (Witness monuments shall be made of concrete, natural stone, iron or other equally durable material.) Describe witness monuments.

(d) Show a plan view drawing depicting the relevant monuments and reference ties which is sufficient in detail to enable accurate relocation of the corner monument if the corner monument is disturbed. Indicate north.

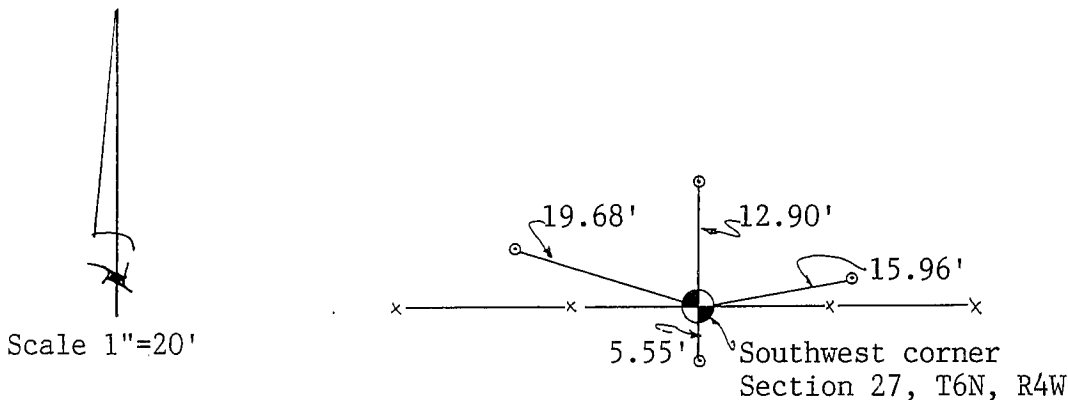

● Set 1 1/4" x 30" Iron Rod

○ Reference ties are 5/8" x 18" Rebars


(e) Describe any material discrepancy between the location of the corner as restored or reestablished and the location of that corner as previously restored or reestablished by distance and direction. Show the discrepancy on the plan view drawing under (d), above. Show the distances between the corner as previously restored or reestablished and (1) the corner as restored or reestablished, and (2) to at least 2 of the witness monuments shown on the drawing in (d), above.

(f) Was the corner restored through acceptance of (1) an obliterated evidence location, or, (2) a found perpetuated location?

(g&h) Was the corner reestablished through lost corner proportionate methods? If so, show the method, including the directions and distances to other public land survey corners used as evidence or used for proportioning in determining the corner location?

No.

(1) I, John M. Halverson
(type or print name) certify that the corner location shown on this record was determined by me or under my direction and control and that this U.S. Public Land Survey Monument Record is correct and complete to the best of my knowledge and belief.

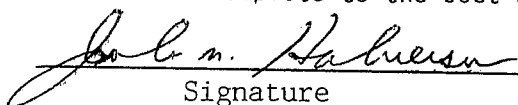
Signature

11/13/92
Date

