


**U.S. PUBLIC LAND SURVEY MONUMENT RECORD – GRANT COUNTY, WI**

**Summary of Section 1, Town 6 North, Range 4 West, Town of Woodman**

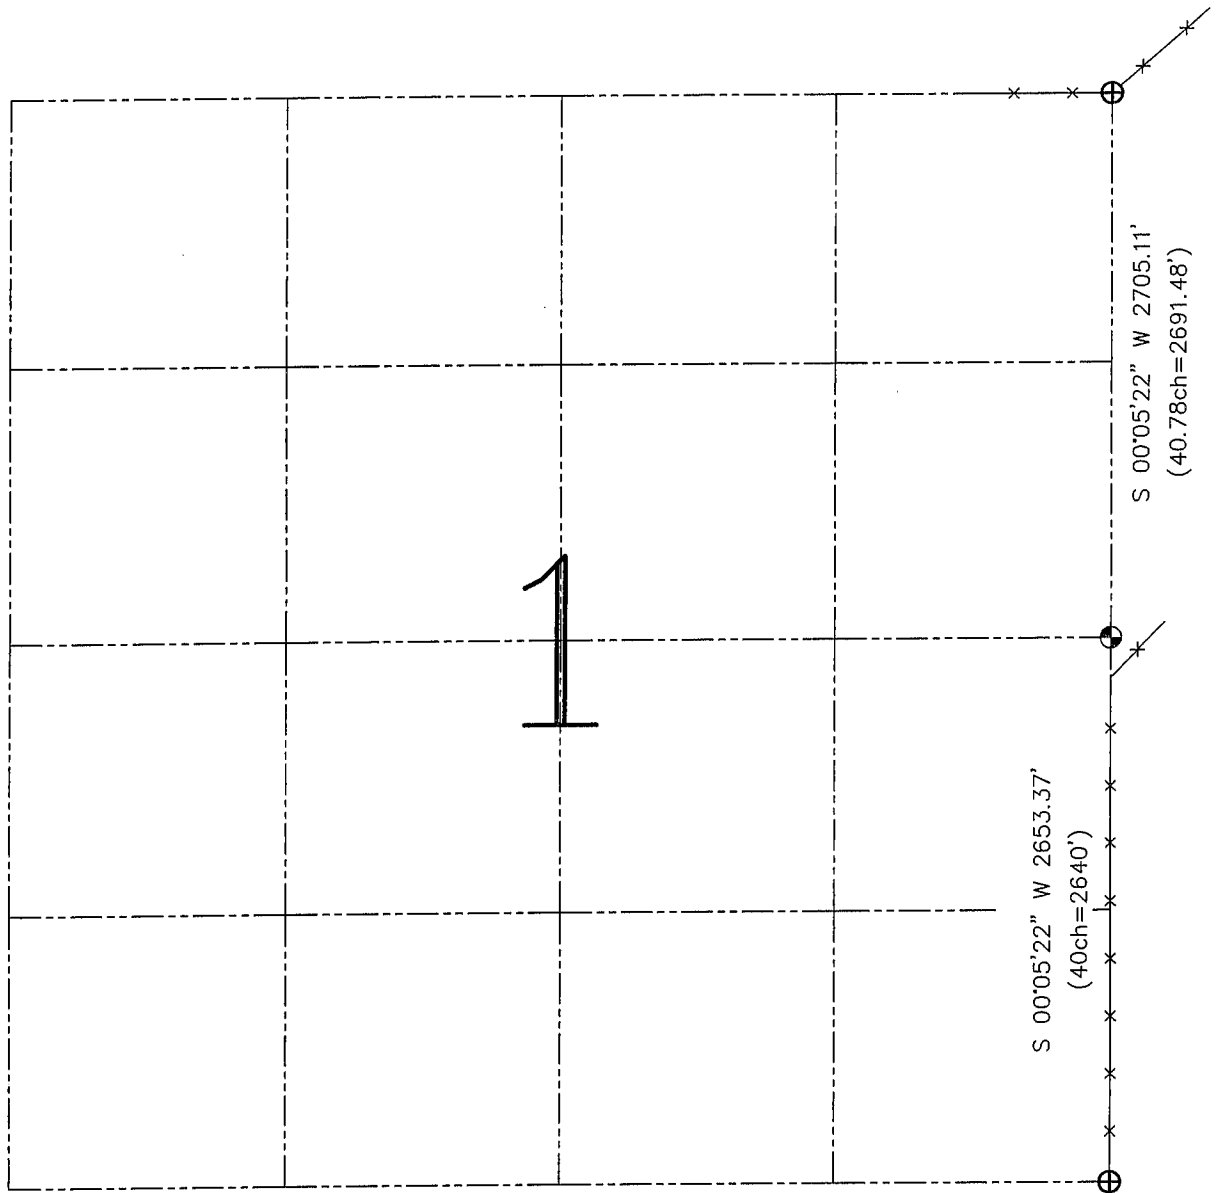


**LEGEND**

- ⊕ No. 8 rebar found with Grant County Aluminum Cap
- ⊙ No. 8 x 30" rebar set with Grant County Aluminum Cap – wt=2.67#/l.f.
- ) Recorded as
- Approximate location of existing fence

Relationship of all section corners to other section corners shall be shown hereon by bearing and distance or grid coordinates. Bearing reference shown below.

Dated this 21st day of January 2003

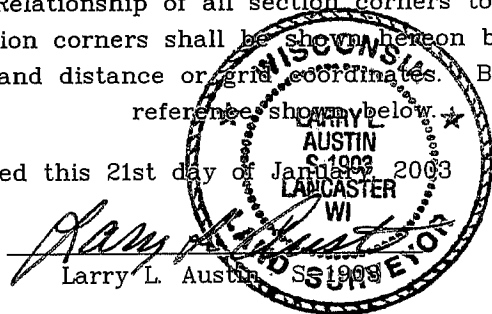

Bearings referenced to the East line of the Southeast Quarter of this Section, which is assumed to bear S 00°05'22" W.

SKETCH NOT TO SCALE