


U.S. PUBLIC LAND SURVEY MONUMENT RECORD – GRANT COUNTY, WI

Summary of Section 17, Town 6 North, Range 4 West, Town of Mount Hope

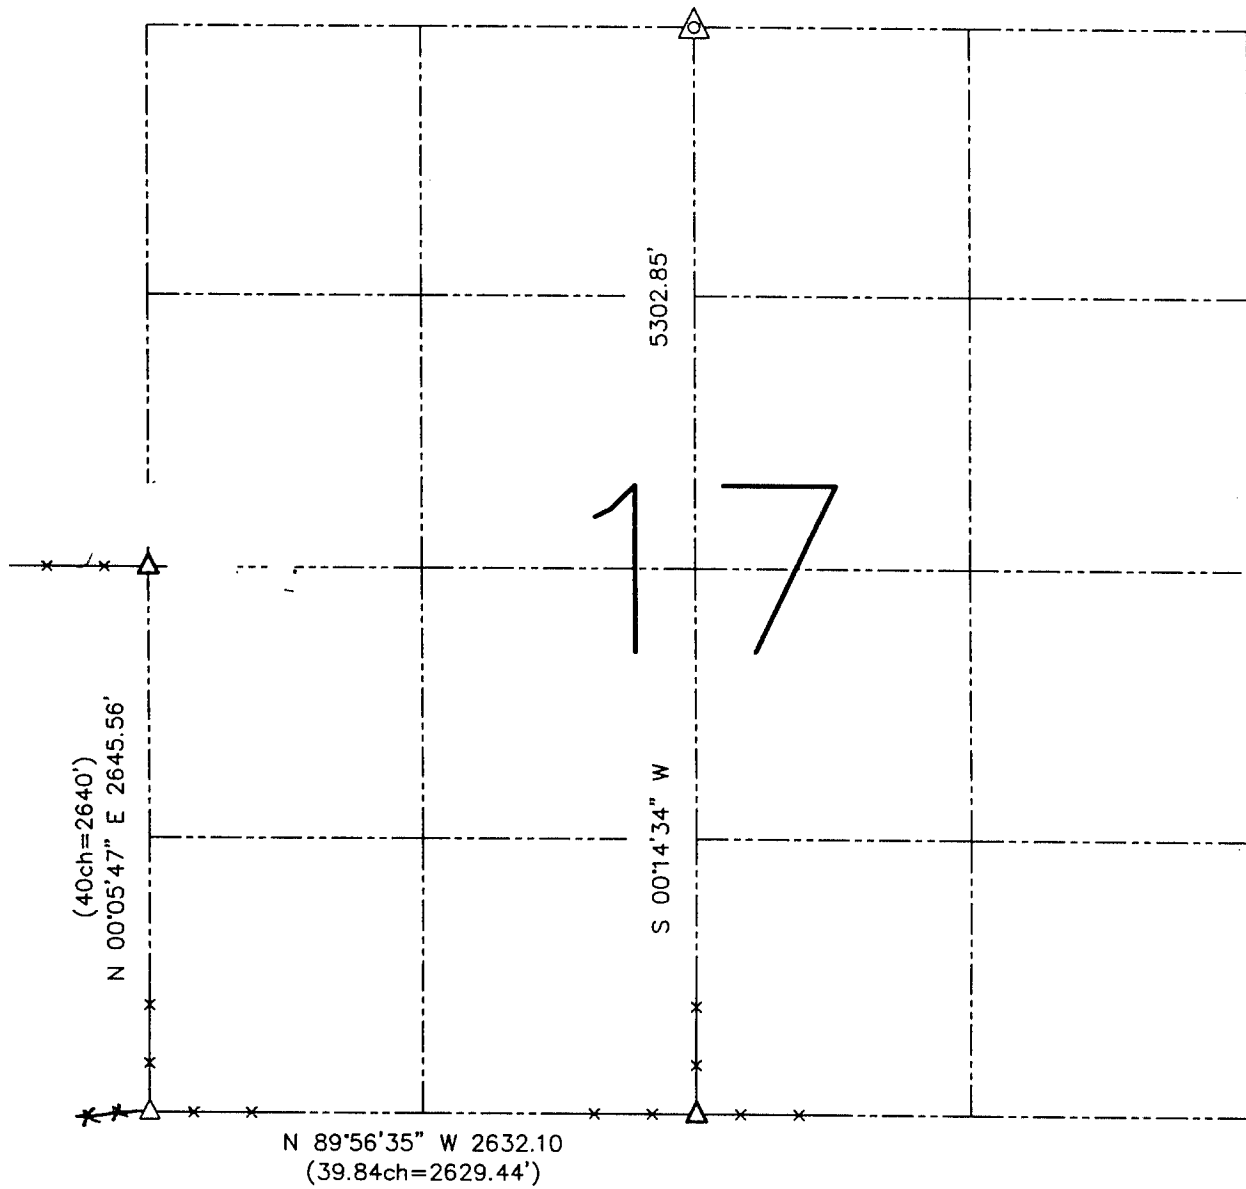


LEGEND

- No. 7 rebar found
- △ 1" diameter iron pipe found
- ⊙ 1 1/2" diameter iron pipe found
- () Recorded as
- x— Approximate location of existing fence

Relationship of all section corners to other section corners shall be shown hereon by bearing and distance or grid coordinates. Bearing reference shown below.

Dated this 22nd day of September, 2002

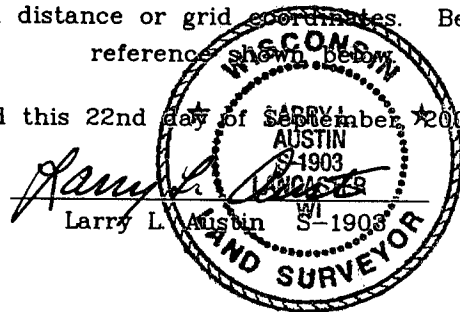

Bearings referenced to the South line of the Southwest Quarter line of this Section, which is assumed to bear N 89°56'35" W.

SKETCH NOT TO SCALE

AUSTIN ENGINEERING, LLC
 4211 HWY 81 EAST, LANCASTER, WI 53813
 PHONE 608-723-6363 FAX 608-723-6702

FIELDBOOK: SDR33, 2220
 G:\T6NR5W\13
 C:\SWA\TIE\T6NR4W\17SUM

CREW: BS-SB-SA-BD
 DRAWN BY: SW AUSTIN
 APPROVED: LL AUSTIN