


REC'D MAR 3 1997

GRANT COUNTY U.S. PUBLIC LAND SURVEY MONUMENT RECORD

TYPE OF MONUMENT: 3/4" X 24" Iron Rod
TIES ARE AS INDICATED ON SKETCH

WITNESSES TO CORNER LOCATION

Sean M. Walsh
Christopher G. Reedy

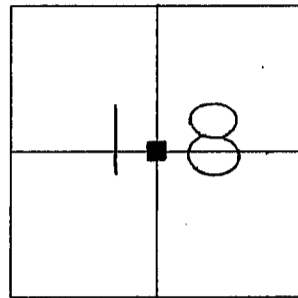

CORNER LOCATION

Center 1/4 Corner
Section 18
Town 6 North, Range 5 West
Millville Township

BASIS FOR MONUMENT LOCATION

I have accepted and perpetuated this corner at this location of physical occupation as there is no other acceptable evidence.

I do hereby certify that the information contained hereon is correct and true to the best of my information, knowledge and belief.



- - 3/4" X 24" Iron Rod Set at Corner
- - 3/4" X 24" Iron Rod Set as Tie

The tree tie is a 60d common pole spike set in a blaze at the base of the tree as indicated.

Tie distances were taped horizontally.

The rod set at this corner is located on the West side of a large railroad tie fence corner post.

TIE SKETCH

