

GRANT COUNTY CERTIFIED LAND CORNER

CORNER NUMBER 81

CERTIFICATE:


I, Larry L. Austin, do hereby certify that on the 14th day of February, 2000, I found evidence of the Northeast corner of Section 25, Town 6 North, Range 5 West, of the 4th Principal Meridian, and I re-established said corner according to the Wisconsin statutes as shown and described hereon.

Dated this 20th day of March, 2000

Larry L. Austin
Larry L. Austin S-1903



SEAL

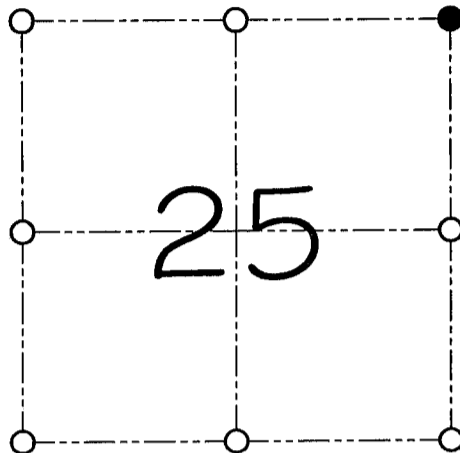

● = CORNER LOCATION

**NORTHEAST CORNER OF
SECTION 25, T 6 N R 5 W
TOWN OF MOUNT HOPE**

HISTORY OF ORIGINAL CORNER ESTABLISHMENT:

Corner was originally set in 1832 by Sibley.
In 1995 Robert Lampman tied to the corner.

DESCRIPTION OF CORNER EVIDENCE FOUND:

Lampman tied to the Northwest corner of Section 30, T6N R4W and did not use the recorded offset. I set the corner at the recorded offset from the Northwest corner of Section 30, T6N R4W. Verified this location using E.D.M. and G.P.S. methods.

DESCRIPTION OF CORNER AND WITNESS MONUMENTS, references and accessories used to perpetuate the original or re-established location of this corner

WITNESS TO THE CORNER LOCATION: SHANE AUSTIN & SHELBY BLINDERT

SKETCH:

