


U.S. PUBLIC LAND SURVEY MONUMENT RECORD – GRANT COUNTY, WI


Summary of Section 7, Town 6 North, Range 5 West, Town of Millville

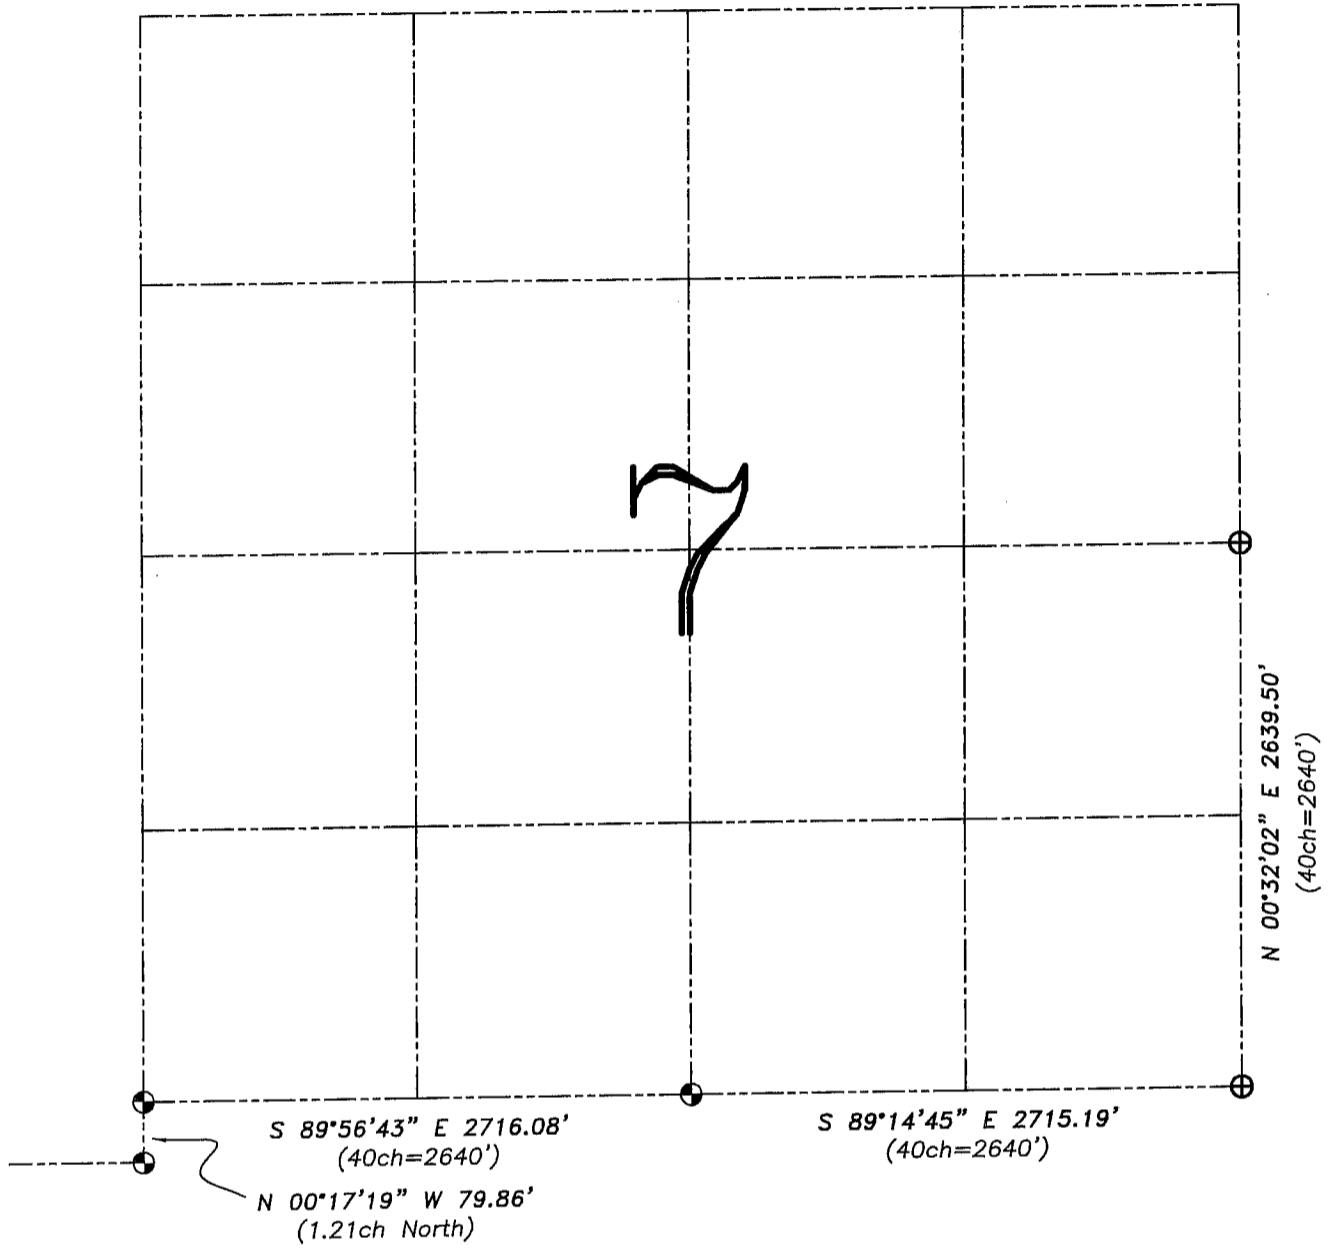

LEGEND

- ⊕ No. 8 rebar found with Grant County Aluminum Cap
- ⊙ No. 8 x 30" rebar set with Grant County Aluminum Cap – wt=2.67#/l.f.
- () Recorded as
- x— Approximate location of existing fence

Relationship of all section corners to other section corners shall be shown hereon by bearing and distance or grid coordinates. Bearing reference shown below.

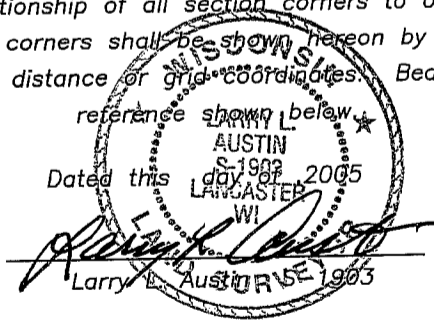

Bearings referenced to the South line of the SW 1/4 of this Section, which is assumed to bear **S 89°56'43" E**

SKETCH NOT TO SCALE



Austin Engineering LLC

4211 HWY 81 E, LANCASTER, WI 53813
PHONE 608-723-6363 FAX 608-723-6702

JOB NUMBER: 05S034
FIELDBOOK: TDSR, 2505
G:\T6NR6W\18
H:\TIE\T6NR5W\07SUM

DRAWN BY: SW AUSTIN
APPROVED: LL AUSTIN