

**U.S. PUBLIC LAND SURVEY MONUMENT RECORD – GRANT COUNTY, WI**



**Section 13, Town 6 North Range 6 West, Town of Wyalusing**

CERTIFICATE

I, Larry L. Austin, do hereby certify that the corner location on this record was determined by me and/or under my direct supervision and that this U.S. public land survey monument record is correct and complete to the best of my knowledge and belief.

Dated this 18th day of April, 2005

Larry L. Austin

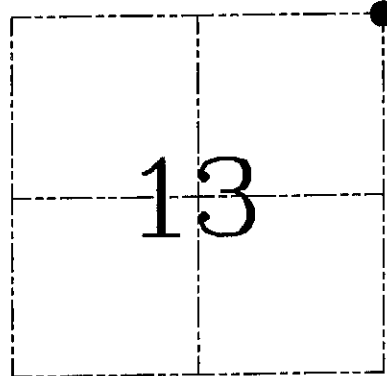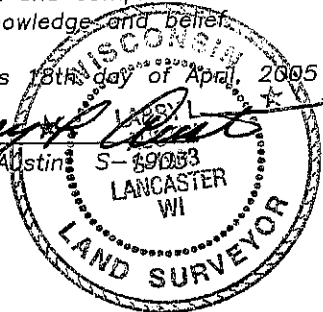

● = CORNER LOCATION

HISTORY OF CORNER ESTABLISHMENT



Corner was originally set in 1832 by Sibley.  
No other record of the corner was found.

DESCRIPTION OF CORNER EVIDENCE FOUND

I set the corner at the recorded distance of 1.5 chains North of the Wisconsin river bluff and on-line with fence South. Verified this location using EDM & GPS methods.

DESCRIPTION OF CORNER AND WITNESS MONUMENTS, references and accessories used to perpetuate the original or re-established location of this corner. Witnesses to corner location Brad Digman & Shane Austin.

**SKETCH:**

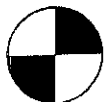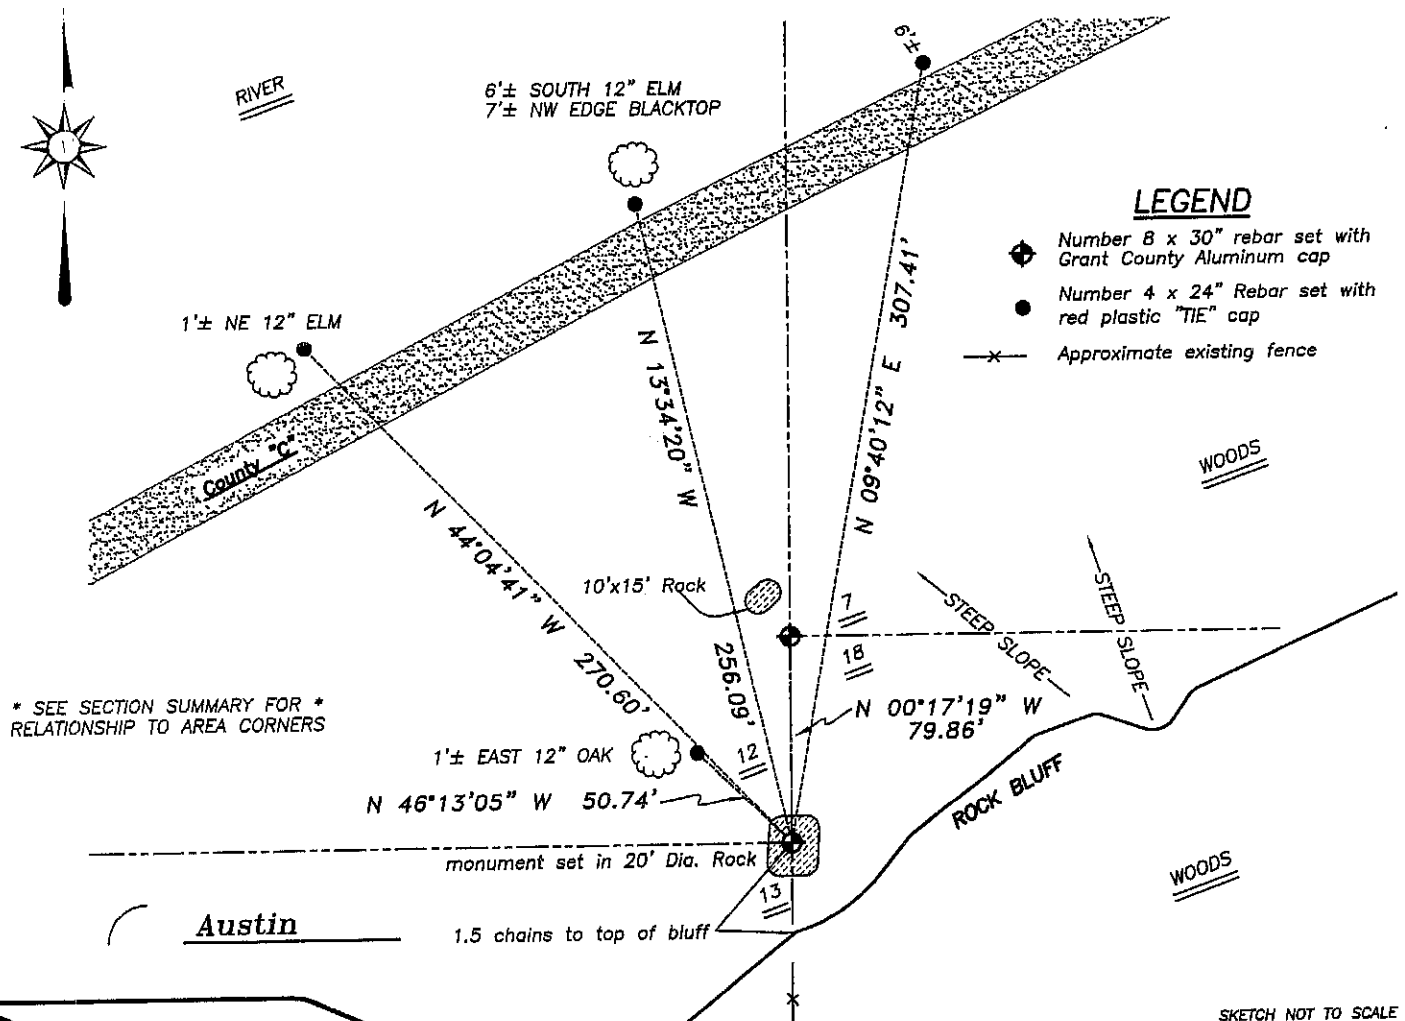

**Engineering LLC**

4211 HWY 81 E, LANCASTER, WI 53813  
PHONE 608-723-6363 FAX 608-723-6702

JOB NUMBER 05S034  
FIELDBOOK: TDSR, 2505  
G:\T6NR6W\18  
H:\TIE\T6NR6W\41

DRAWN BY: BJ HAZEN  
APPROVED: LL AUSTIN