

U.S. PUBLIC LAND SURVEY MONUMENT RECORD - GRANT COUNTY, WI

Section 13, Town 6 North Range 6 West, Town of Wyalusing (a)



NOTE: This form is intended and designed to fulfill all requirements of the Wisconsin Administrative Code Chapter A-E 7.08, U.S. Public Land Survey Monument Record (3) (a) (b) (c) (d) (e) (f) (g) (h) (i).

CERTIFICATE: (i)

I, Aaron J. Austin, Wisconsin Professional Land Surveyor, do hereby certify that the corner location on this record was determined by me and/or under my direct supervision and that this U.S. Public Land Survey Monument Record is correct and complete to the best of my knowledge and belief.

Dated this 11th day of March, 2026.

Aaron J. Austin
Aaron J. Austin, PLS-2922

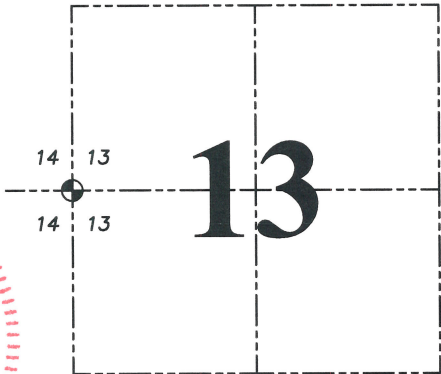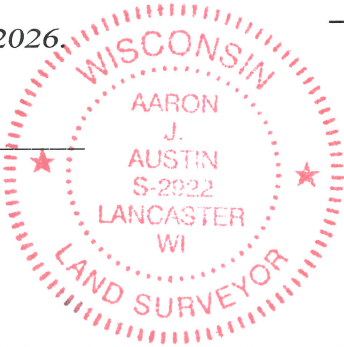

⊙ = CORNER LOCATION

Grant County Coordinates:
NAD 83 (2011)
Northing: 577,635.38
Easting: 730,082.81

HISTORY OF CORNER ESTABLISHMENT:

Original corner was set in 1833 by Robert Clark.
Highway Plan Project S 0576(3) shows the corner with no dimensions.

DESCRIPTION OF CORNER EVIDENCE FOUND: (b) (f) (g) (h)

I set a 1" x 24" Rebar online with fence remains to the West which fit with a East-West fence to the East. I held 68' from the Centerline of County Highway "C" per Document #425966 which coincides with the Highway Plan. I set four witness corners and I verified the Monument's location with G.P.S. methods.

DESCRIPTION OF CORNER AND WITNESS MONUMENTS, references and accessories used to perpetuate the original or re-established location of this corner. (c) (d) (e)

Witnesses to corner location Shane Austin, Owen Austin, Tanner Austin.
Drawn by: Owen Austin.

SKETCH:

LEGEND

- ⊙ Section Corner—as designated
- 3/4" x 18" rebar set
- + No monument set
- x-x-x- Existing fence
- ~~~~~ Edge of field

