


U.S. PUBLIC LAND SURVEY MONUMENT RECORD - GRANT COUNTY, WI
 Section 29, Town 6 North Range 6 West, Town of Wyalusing

CERTIFICATE

I, Larry L. Austin, do hereby certify that the corner location on this record was determined by me and/or under my direct supervision and that this U.S. public land survey monument record is correct and complete to the best of my knowledge and belief.

Dated this 7th day of November, 2004

Larry L. Austin
 Larry L. Austin S-1903

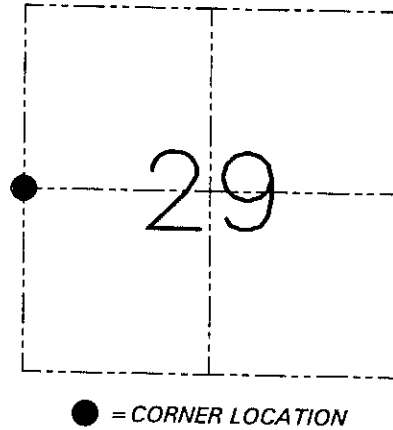

HISTORY OF CORNER ESTABLISHMENT


Corner was originally set in 1832 by Robert Clark.
 In 1994 Roger Mohn set a #6 iron bar.

DESCRIPTION OF CORNER EVIDENCE FOUND

I found Mohn's #6 iron bar and accepted it's location after an EDM & GPS traverse of the area.

DESCRIPTION OF CORNER AND WITNESS MONUMENTS, references and accessories used to perpetuate the original or re-established location of this corner. Witnesses to the corner location Bobby Sedgwick & Shelby Blindert & Dustin Maas

SKETCH:

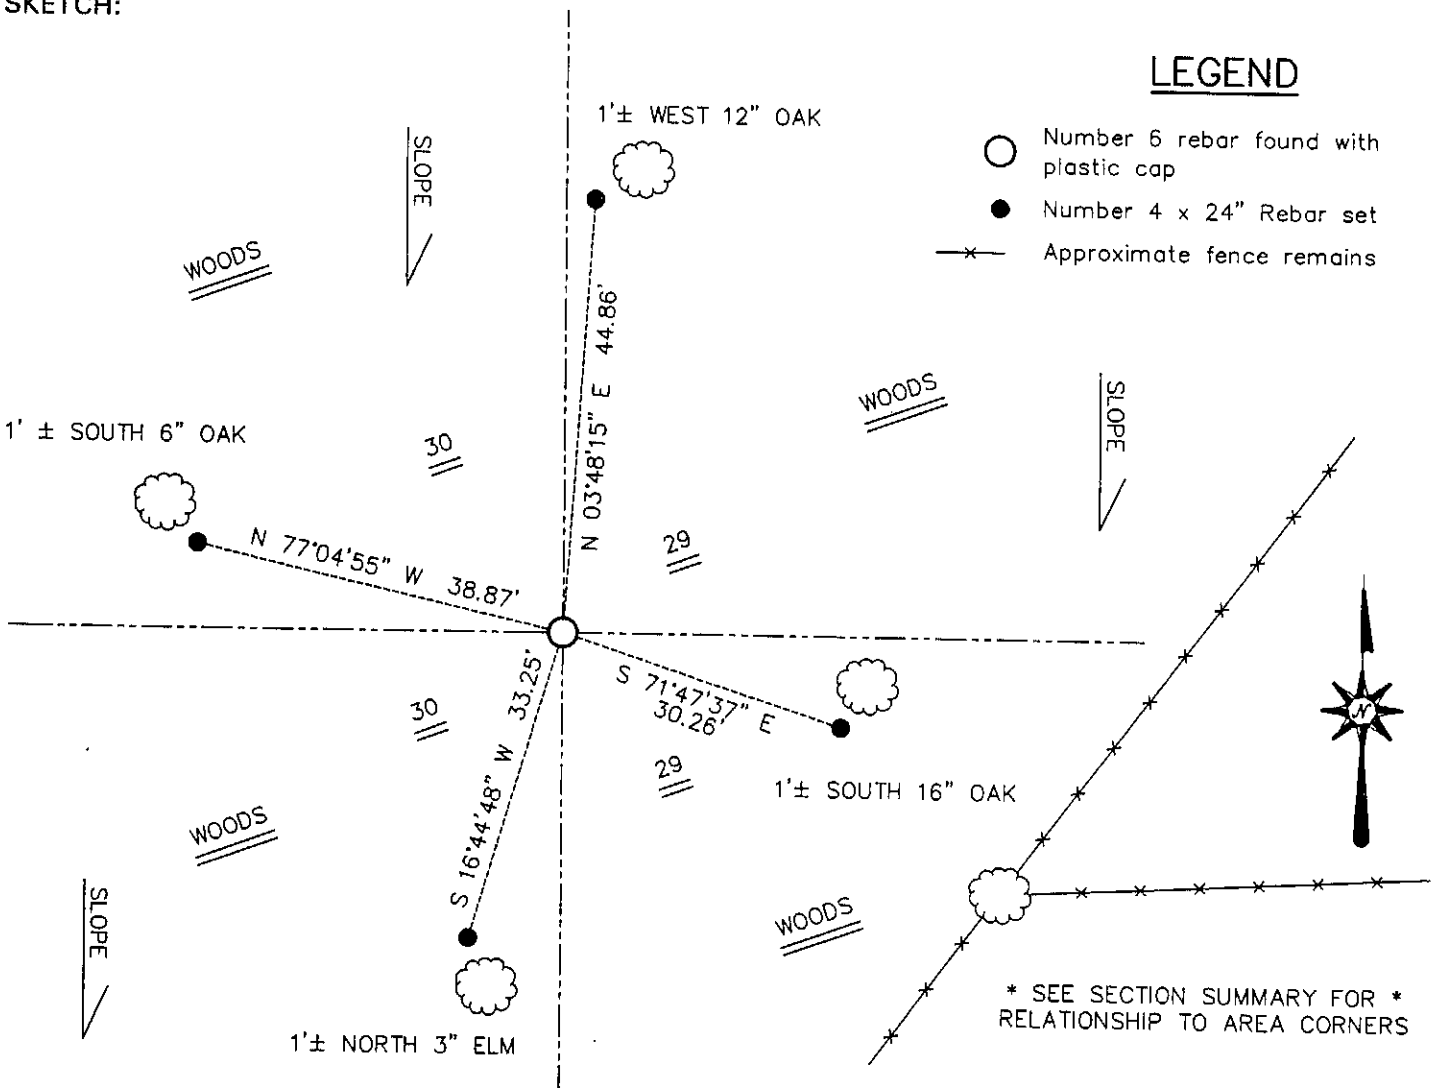

LEGEND

- Number 6 rebar found with plastic cap
- Number 4 x 24" Rebar set
- x- Approximate fence remains

* SEE SECTION SUMMARY FOR *
 RELATIONSHIP TO AREA CORNERS

SKETCH NOT TO SCALE

AUSTIN ENGINEERING, LLC

4211 HWY 81 EAST, LANCASTER, WI 53813
 PHONE 608-723-6363 FAX 608-723-6702

FIELDBOOK: SDR33, 2114
 G: \T6NR6W\33
 C: \SWA\TIE\T6NR6W\95
 CREW: BS-SB-SA-DM

DRAWN BY: SW AUSTIN
 APPROVED: LL AUSTIN

CORNER NUMBER 95