


Survey Monument Record

TYPE OF MONUMENT 3/4" X 24" IRON BAR SET

CORNER NO. 107
 SECTION 34
 TOWN 6N
 RANGE 6W

FIELD BOOK: 95-19
 PAGE 33

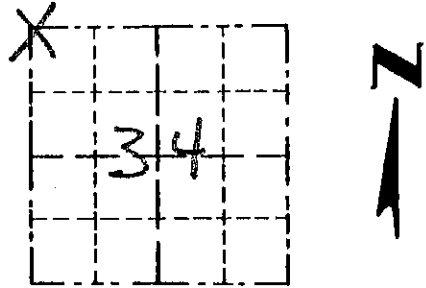

LOCATION
 (Indicated by "X")

BASIS FOR MONUMENT LOCATION

(Use reverse side if necessary)

Show info such as: History of corner, with reference to Vol. and pg., dates, surveyor; exact description of monument replaced; if location computed, by taped or EDM traverse; landowner, remarks, etc.

SEAL:

CORNER SET IN 1832 BY
 ROBERT CLARK, NO RECORD
 FOUND SINCE ORIGINAL SURVEY;
 CORNER WAS SET AT A OCCUPIED
 LOCATION, CENTERLINE NORTH/SOUTH,
 FNC WEST, VERIFIED ITS LOCATION
 1/2 MILE SOUTH/NORTH/EAST,
 VERIFIED THIS LOCATION USING
 EDM METHODS.



CERTIFIED CORRECT

Larry L. Austin
 Registered Land Surveyor

DATE: 4/13/98

TIE SKETCH

Show at least three (3) ties and monument

LEGEND

- ⊕ 3/4" X 24" IRON BAR SET
- 1/2" X 15" IRON BAR SET
- ⊕ POWER POLE
- *** EXISTING FENCE

