


Survey Monument Record

TYPE OF MONUMENT 3/4" X 24" IRON BAR SET

CORNER NO. 117
 SECTION 34
 TOWN 6N
 RANGE 6W

FIELD BOOK: 95-19
 PAGE (30)

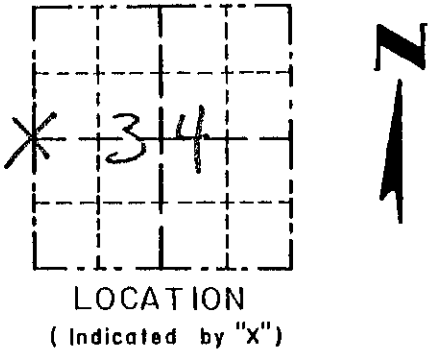


BASIS FOR MONUMENT LOCATION

(Use reverse side if necessary)
 Show info such as: History of corner, with reference to Vol. and pg., dates, surveyor; exact description of monument replaced; if location computed, by taped or EDM traverse; landowner, remarks, etc.

SEAL:

CORNER SET IN 1832 BY ROBERT CLARK. NO RECORD OF CORNER FOUND SINCE ORIGINAL SURVEY; CORNER WAS SET AT A OCCUPIED LOCATION, FENCE E/W/S. VERIFIED IT 1/2 MILE NORTH USING EDM METHODS.

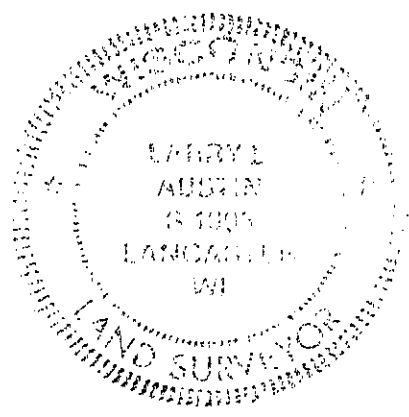


CERTIFIED CORRECT
Emery L. Austin
 Registered Land Surveyor
 DATE: 4/13/98

TIE SKETCH

Show at least three (3) ties and monument

LEGEND

- ⊕ 3/4" X 24" IRON BAR SET
- 1/2" X 15" IRON BAR SET
- ** EXISTING FENCE Woods

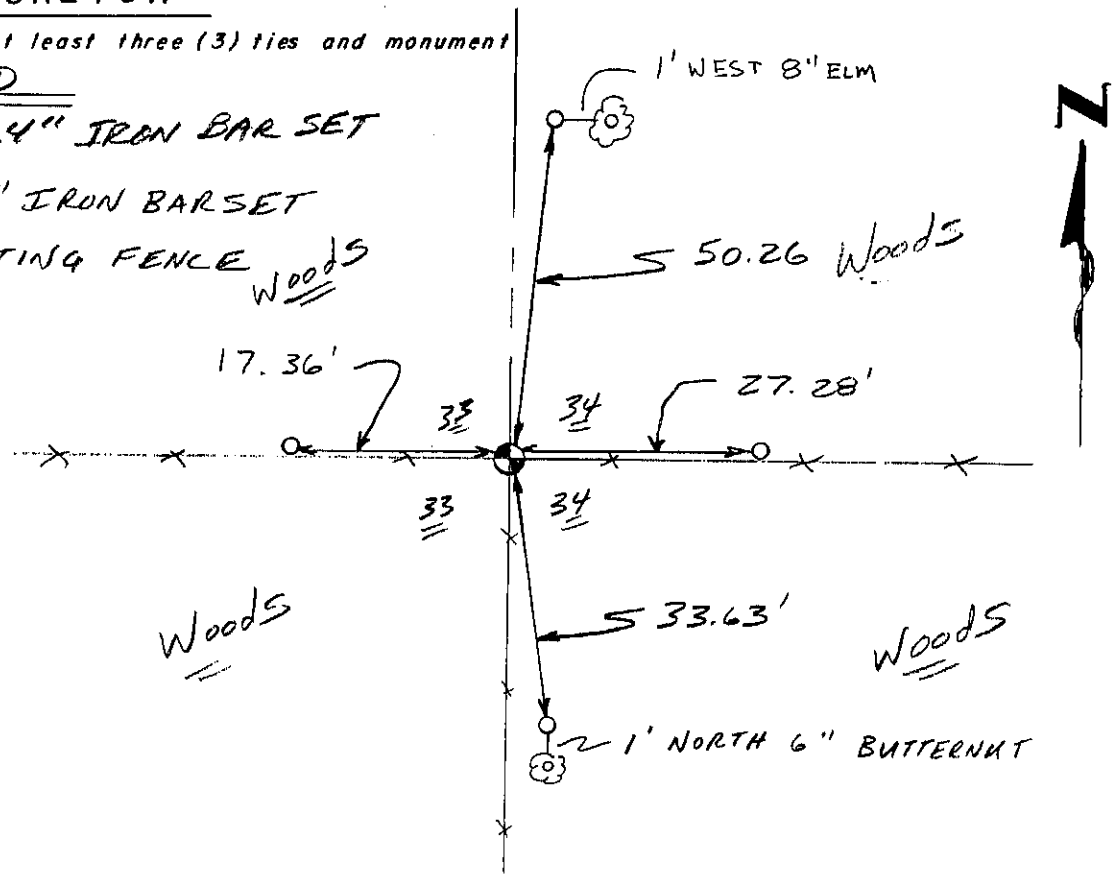

No SCALE