





U.S. PUBLIC LAND SURVEY MONUMENT RECORD - GRANT COUNTY, WI
 Summary of Section 29, Town 6 North Range 6 West, Town of Wyalusing

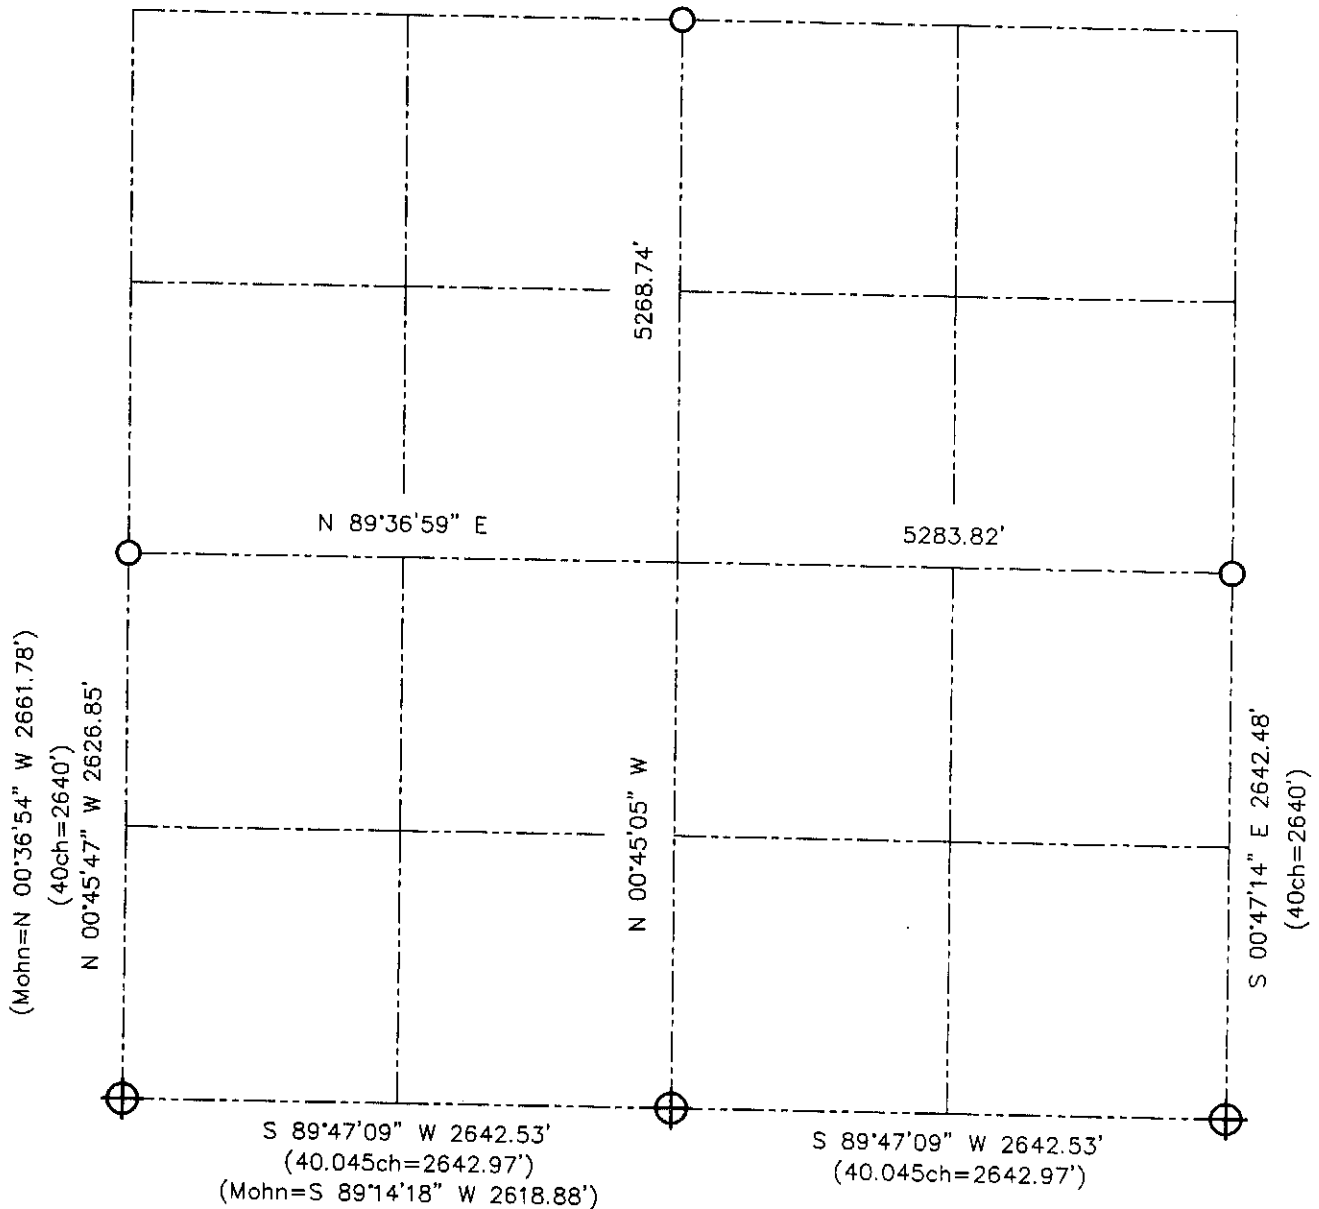

LEGEND

-  NUMBER 8 REBAR FOUND WITH GRANT COUNTY ALUMINUM CAP
-  NUMBER 6 REBAR FOUND WITH PLASTIC CAP
-  RECORDED AS



Relationship of all section corners to other section corners shall be shown hereon by bearing and distance or grid coordinates. Bearing reference shown below.



Bearings referenced to the North line of the Southeast 1/4 of Section 29, which is assumed to bear N 89°36'59\"/>

SKETCH NOT TO SCALE

AUSTIN ENGINEERING, LLC
 4211 HWY 81 EAST, LANCASTER, WI 53813
 PHONE 608-723-6363 FAX 608-723-6702

FIELDBOOK: SDR33, 2114
 G: \T6NR6W\33
 C: \SWA\TIE\T6NR6W\29SUM

CREW: BS-SB-SA-DM
 DRAWN BY: SW AUSTIN
 APPROVED: LL AUSTIN