


SECTION CORNER TIE SHEET INDEX

T. 7 N., R. 1 W

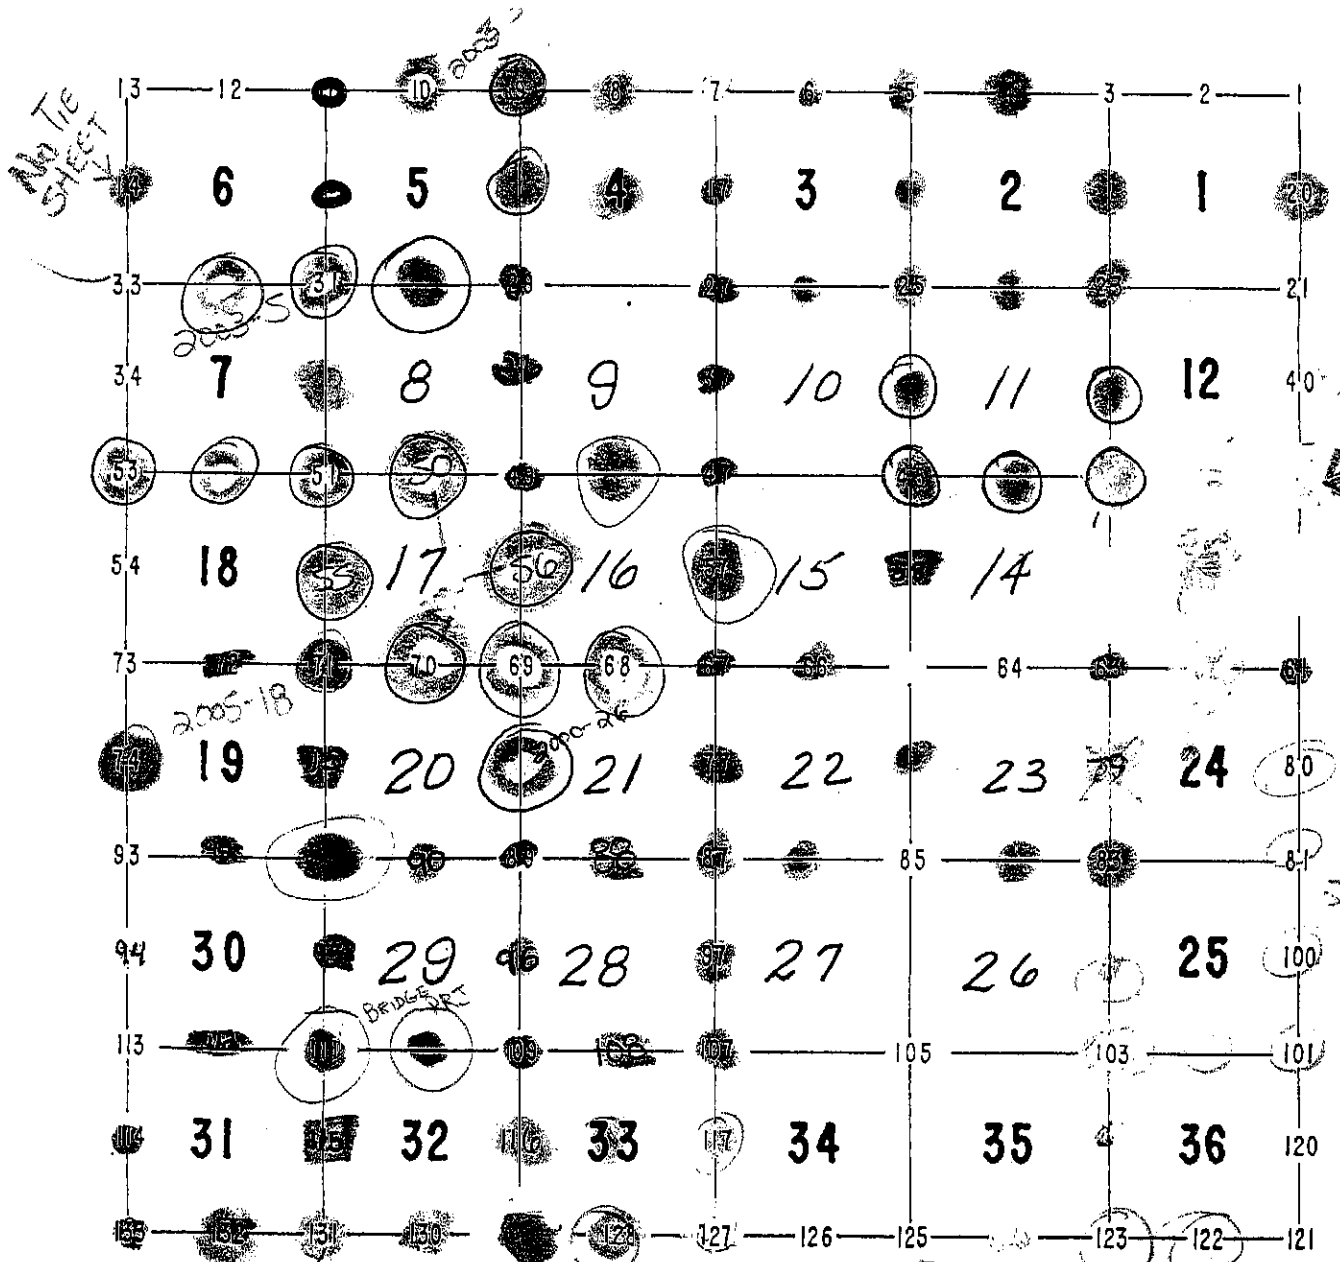

109-1-06

13