

# GRANT COUNTY

## CERTIFIED U.S. PUBLIC LAND SURVEY MONUMENT RECORD

INSTRUCTIONS: THIS RECORD SHALL SHOW THE LOCATION OF THE CORNER AND SHALL INCLUDE ALL OF THE FOLLOWING NINE ELEMENTS (A THROUGH I)

- (A) IDENTIFY THE CORNER BY REFERENCE TO THE U.S. PUBLIC LAND SURVEY SYSTEM  
 ■ = CORNER MONUMENT RESTORED


WITNESSES TO CORNER LOCATION:

TERRY PREM  
 WES KRAEMER  
 JASON PELLOCK

GRANT COUNTY COORDINATES

NORTHING: 622,372.46'

EASTING: 872,675.04'

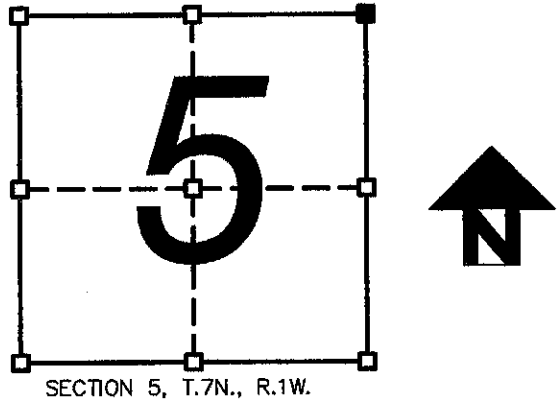


- (B) DESCRIBE ANY RECORD EVIDENCE, MONUMENT EVIDENCE, OCCUPATIONAL EVIDENCE, TESTIMONIAL EVIDENCE, OR ANY OTHER MATERIAL EVIDENCE YOU CONSIDERED, AND WHETHER THE MONUMENT WAS FOUND OR PLACED.

I LOOKED FOR BEARING TREES CALLED FOR IN THE ORIGINAL NOTES FOR THE NORTHEAST CORNER OF SECTION 5, T7N, R1W, AND FOR THE SOUTHEAST CORNER OF SECTION 32, T8N, R1W, BUT DID NOT FIND ANY. TERRY CORNELL NOTES A SPIKE AT A FENCE CORNER IN A SURVEY DATED MARCH 24, 1995. I DID NOT FIND CORNELL'S SPIKE, BUT PLACED THE MONUMENT FOR THE SOUTHEAST CORNER OF SECTION 32 AT THE FENCE CORNER WITH REFERENCE TO CORNELL'S SURVEY DATA. I SET THE MONUMENT FOR THE NORTHEAST CORNER OF SECTION 5 AT THE ORIGINAL GOVERNMENT OFFSET DISTANCE OF 27 LINKS TO THE WEST.

- (C) IN THE PLAN VIEW DRAWING BELOW, PROVIDE REFERENCE TIES TO AT LEAST 4 WITNESS MONUMENTS, OR, IF THE LOCATION IS WITHIN A MUNICIPALITY, TO AT LEAST 2 WITNESS MONUMENTS, (WITNESS MONUMENTS SHALL BE MADE OF CONCRETE, NATURAL STONE, IRON OR OTHER EQUALLY DURABLE MATERIAL). DESCRIBE WITNESS MONUMENTS.

- (D) SHOW A PLAN VIEW DRAWING DEPICTING THE RELEVANT MONUMENTS AND REFERENCE TIES WHICH IS SUFFICIENT IN DETAIL TO ENABLE ACCURATE RELOCATION OF THE CORNER MONUMENT IF IT IS DISTURBED.

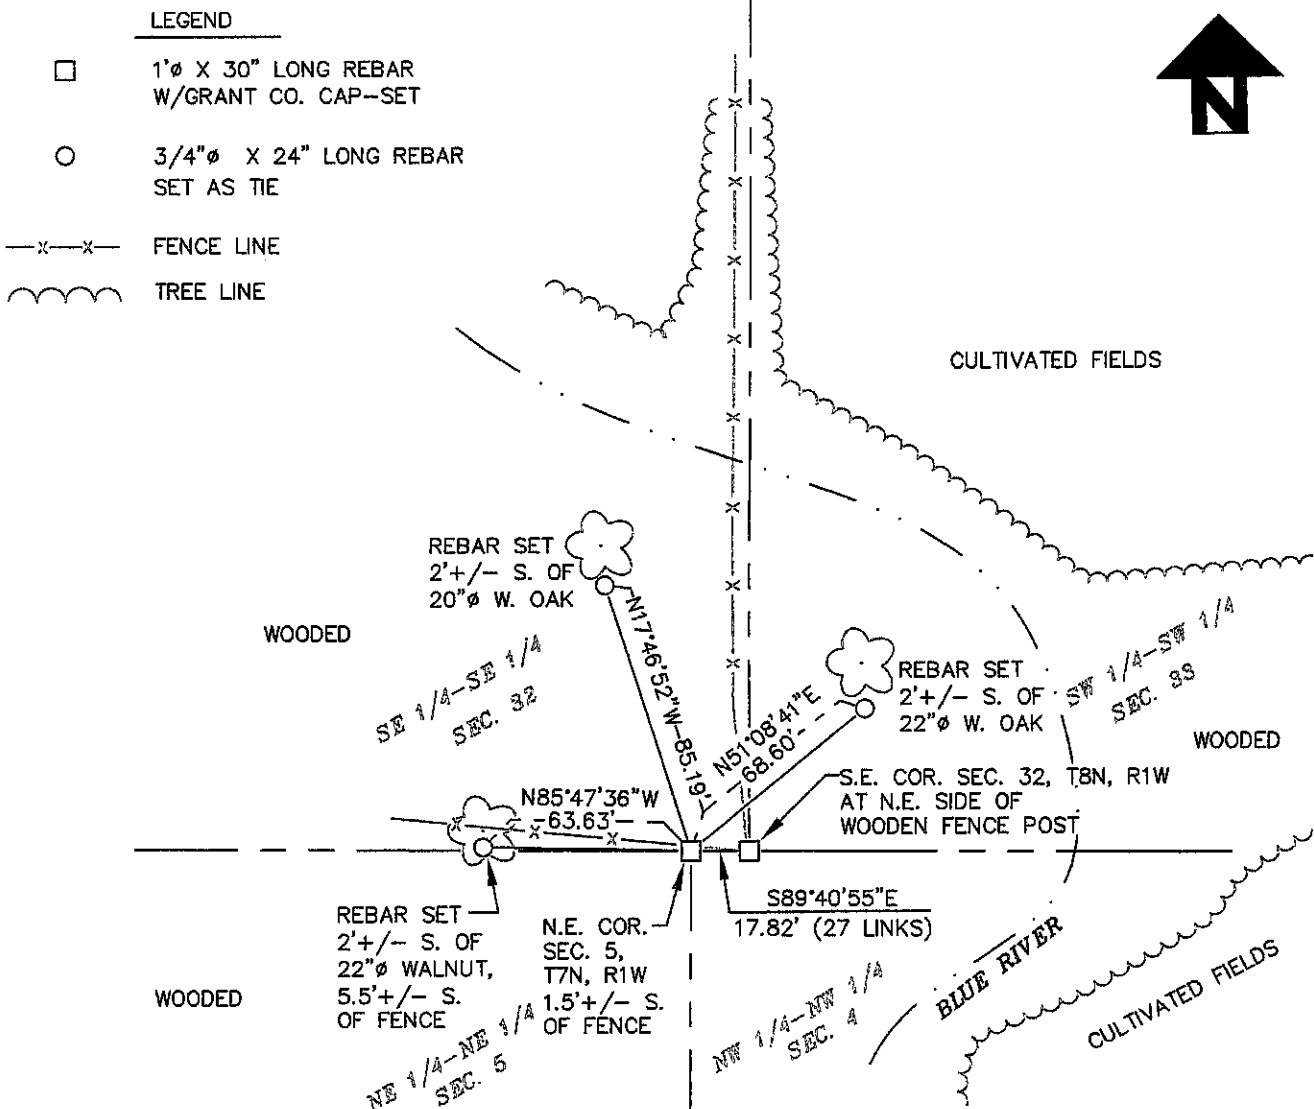

(E) DESCRIBE ANY MATERIAL DISCREPANCY BETWEEN THE LOCATION OF THE CORNER AS RESTORED OR REESTABLISHED AND THE LOCATION OF THAT CORNER AS PREVIOUSLY RESTORED OR REESTABLISHED BY DISTANCE AND DIRECTION. SHOW THE DISCREPANCY ON THE PLAN VIEW DRAWING UNDER (D), ABOVE. SHOW THE DISTANCES BETWEEN THE CORNER AS PREVIOUSLY RESTORED OR REESTABLISHED AND (1) THE CORNER AS RESTORED OR REESTABLISHED, AND (2) TO AT LEAST 2 OF THE WITNESS MONUMENTS SHOWN ON THE DRAWING IN (D) ABOVE.

NO DISCREPANCY FOUND

(F) WAS THE CORNER RESTORED THROUGH ACCEPTANCE OF (1) AN OBLITERATED EVIDENCE LOCATION, OR, (2) A FOUND PERPETUATED LOCATION?


(2) A FOUND PERPETUATED LOCATION.


(G&H) WAS THE CORNER REESTABLISHED THROUGH LOST CORNER PROPORTIONATE METHODS? IF SO, SHOW THE METHOD, INCLUDING THE DIRECTIONS AND DISTANCES TO OTHER PUBLIC LAND SURVEY CORNERS USED AS EVIDENCE OR USED FOR PROPORTIONING IN DETERMINING THE CORNER LOCATION.

NO

AFFIX LAND SURVEYOR SEAL

(I) I, TODD T. RUMMLER, RLS- 2443,  
CERTIFY THAT THE CORNER LOCATION SHOWN ON  
THIS RECORD WAS DETERMINED BY ME OR UNDER MY  
DIRECTION AND CONTROL AND THAT THIS U.S. PUBLIC LAND  
SURVEY MONUMENT RECORD IS CORRECT AND COMPLETE  
TO THE BEST OF MY KNOWLEDGE AND BELIEF.

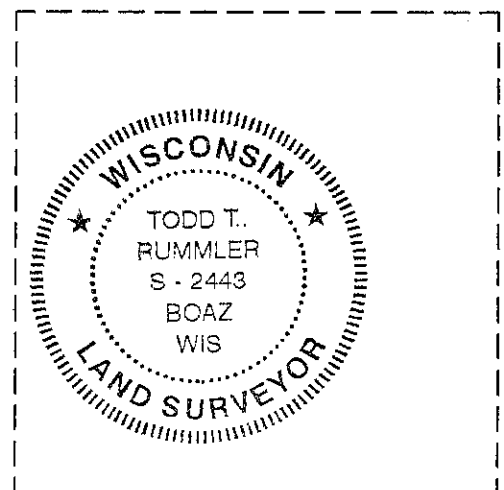

  
SIGNATURE

  
DATE