

U. S. PUBLIC LAND SURVEY MONUMENT RECORD

INSTRUCTIONS: This record shall show the location of the corner and shall include all of the following nine elements (a through i).


- (a) Identify the corner by reference to the U.S. public land survey system.
 ⊕ = Corner monument restored.

Northwest corner
 Section 7, Town 7 North, Range 1 East,
 Town of Highland

COUNTY COORDINATES

N 206092.21
 E 299244.86

Set 1½"x30" Solid Iron Rebar

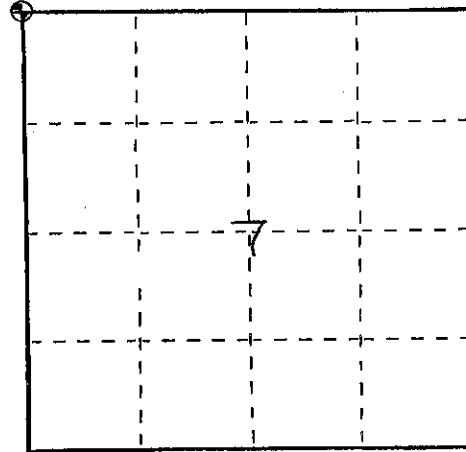

- (b) Describe any record evidence, monument evidence, occupational evidence, testimonial evidence or any other material evidence you considered, and whether the monument was found or placed.

I located an existing fence north-south-east at this corner. A Plat of Survey completed by David Davis in 1980 has a tie to this corner. Found no evidence of anything being set. I set a 1½"x30" solid iron rebar at fence location. Fit the tie from Davis survey very good.

- (c) In the plan view drawing below, provide reference ties to at least 4 witness monuments, or, if the location is within a municipality, to at least 2 witness monuments. (Witness monuments shall be made of concrete, natural stone, iron or other equally durable material.) Describe witness monuments.

- (d) Show a plan view drawing depicting the relevant monuments and reference ties which is sufficient in detail to enable accurate relocation of the corner monument if the corner monument is disturbed. Indicate north.

