
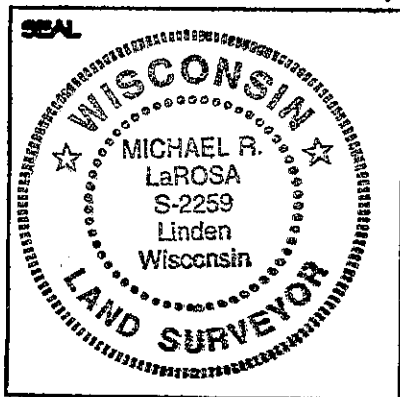


# SECTION SUMMARY SHEET

SECTION 7 T 7 N R/W

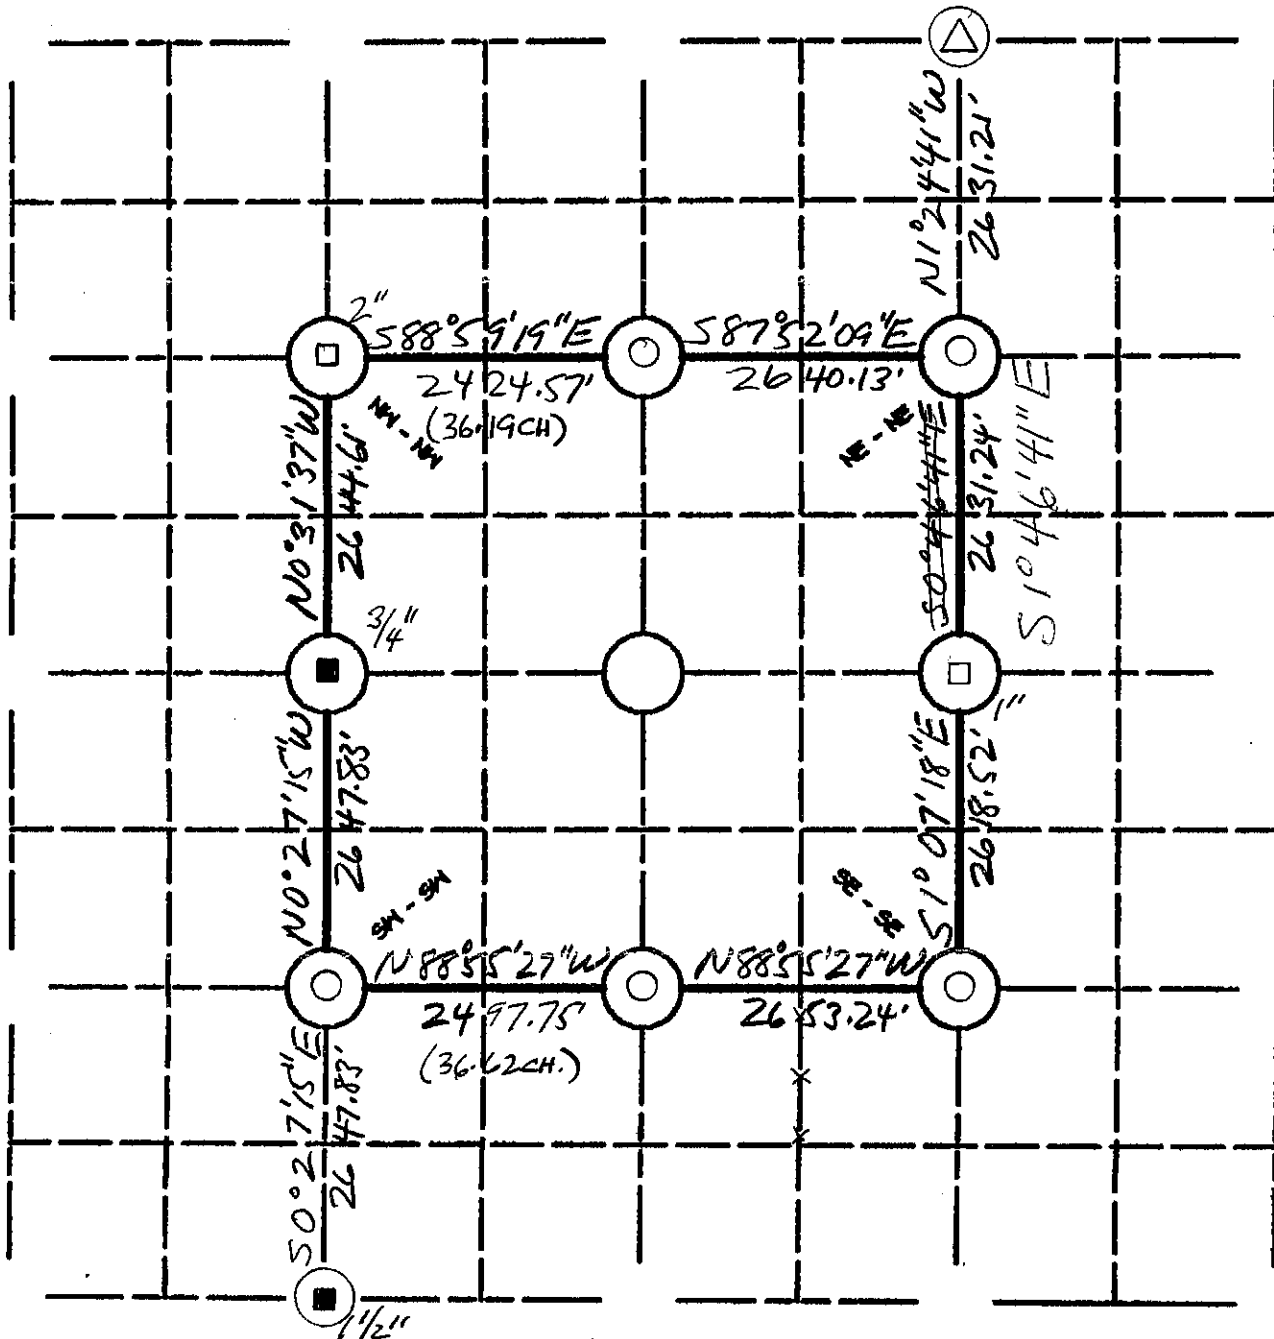

### LEGEND:

- COUNTY MONUMENT SET
- COUNTY MONUMENT FOUND
- OTHER (Specify) Pipe found sizes as noted
- OTHER (Specify) Iron Rod found sizes as noted

OTHER (Specify) \_\_\_\_\_

OTHER (Specify) \_\_\_\_\_

BEARING REF. Grant Co. Coord. System

Grant Co. Coord. System

*Michael R. LaRosa*  
 8/21/2003  
 Revised 5/13/06 M.R.

SIGNATURE DATE

Horiz. Datum	<input type="checkbox"/> NAD 27
	<input type="checkbox"/> NAD 83(NAD83)
Units	<input type="checkbox"/> ENGLISH
	<input type="checkbox"/> Metric
Co-ordinate System	<input type="checkbox"/> Geodetic
	<input type="checkbox"/> State Plane(s, zone)
	<input checked="" type="checkbox"/> Grant County

The information provided in this box is not req'd, but requested to be provided if available to the surveyor preparing this sheet; otherwise provide reference in accordance with survey plat related to preparation of this sheet.

Place coordinates furnished adjacent to the corner(s) on section sketch above.