


SECTION SUMMARY SHEET

SECTION 16 T 7 N R/W

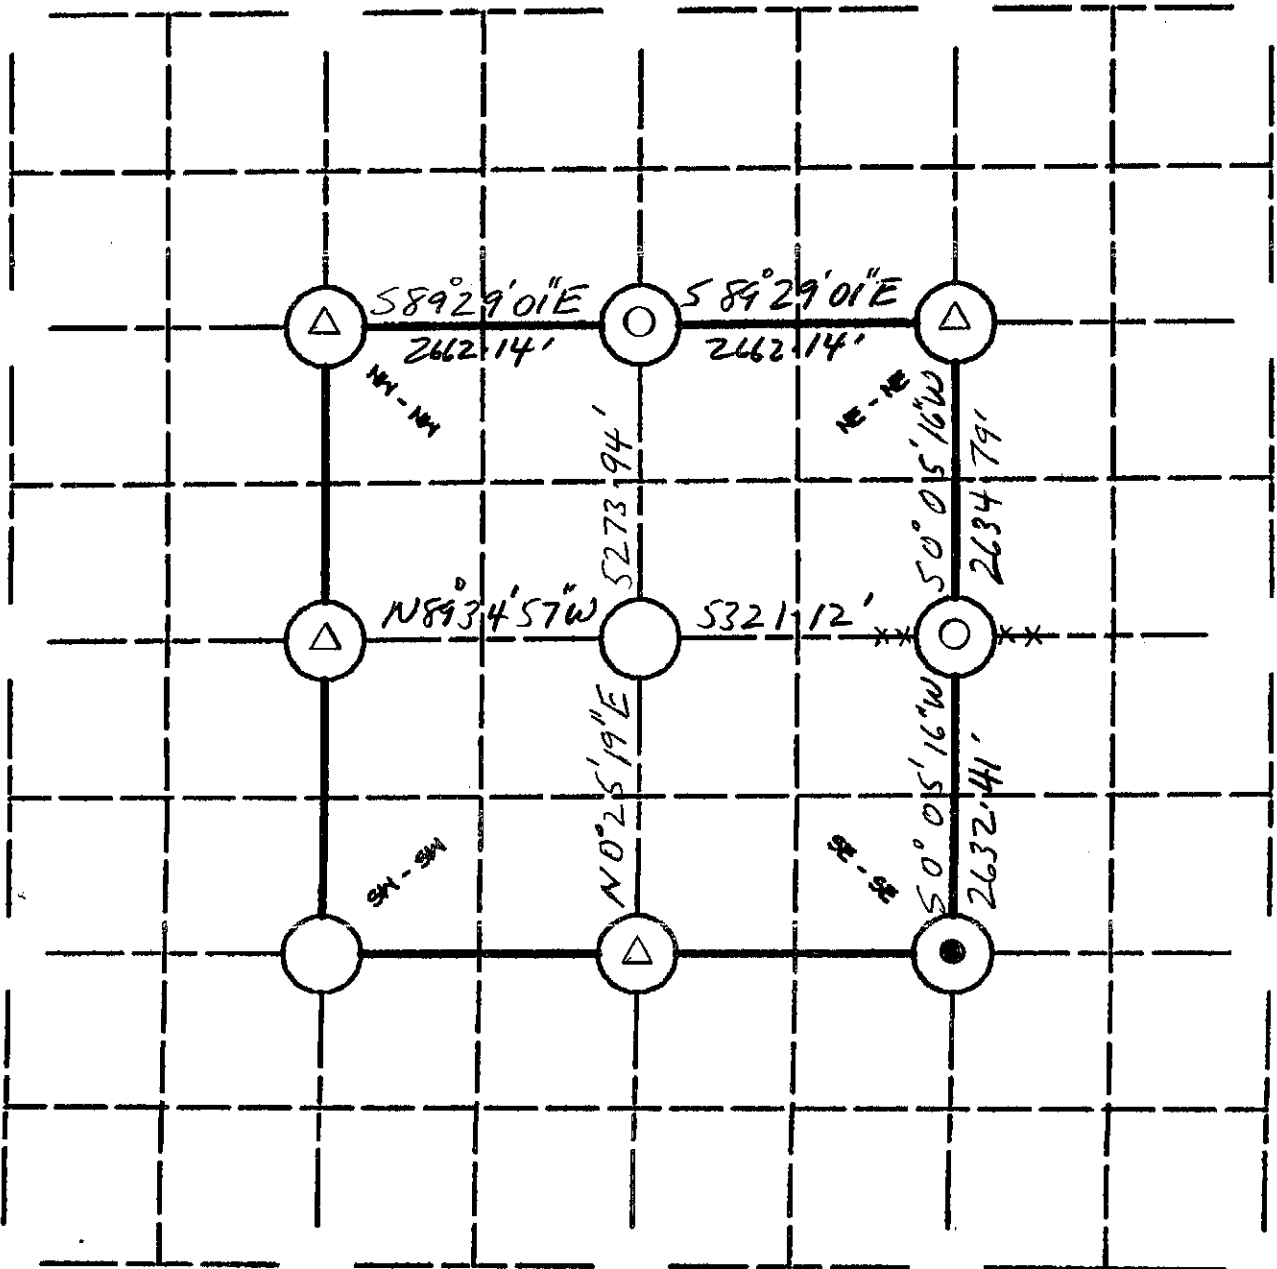

LEGEND:

- COUNTY MONUMENT SET 1" X 30" IRON ROD w/ ALUM. CAP
- △ COUNTY MONUMENT FOUND
- OTHER (Specify) 3/4" IRON ROD FOUND

OTHER (Specify) _____

OTHER (Specify) _____

OTHER (Specify) _____

BEARING REF. Grant Co. Coord. System

Michael R. LaRosa
Michael R. LaRosa
 11/15/2004
 SIGNATURE DATE

HORIZ. DATUM	
<input type="checkbox"/>	NAD 27
<input checked="" type="checkbox"/>	NAD 83(11)
UNITS	
<input checked="" type="checkbox"/>	ENGLISH
<input type="checkbox"/>	Metric
Co-ordinate System	
<input type="checkbox"/>	Geodetic
<input type="checkbox"/>	State Plane(S. zone)
<input checked="" type="checkbox"/>	Lat. County Grant

The information provided in this box is not req'd, but requested to be provided if available to the surveyor preparing this sheet; otherwise provide reference in accordance with survey plat related to preparation of this sheet.

Place coordinates furnished adjacent to the corner(s) on section sketch above.