
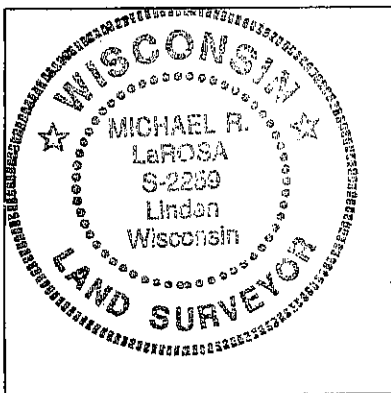


SECTION SUMMARY

PLAT OF SURVEY
FOR: BILL STANEK

SHEET 2 OF 3
JOB #2003-60
CREW ML SS

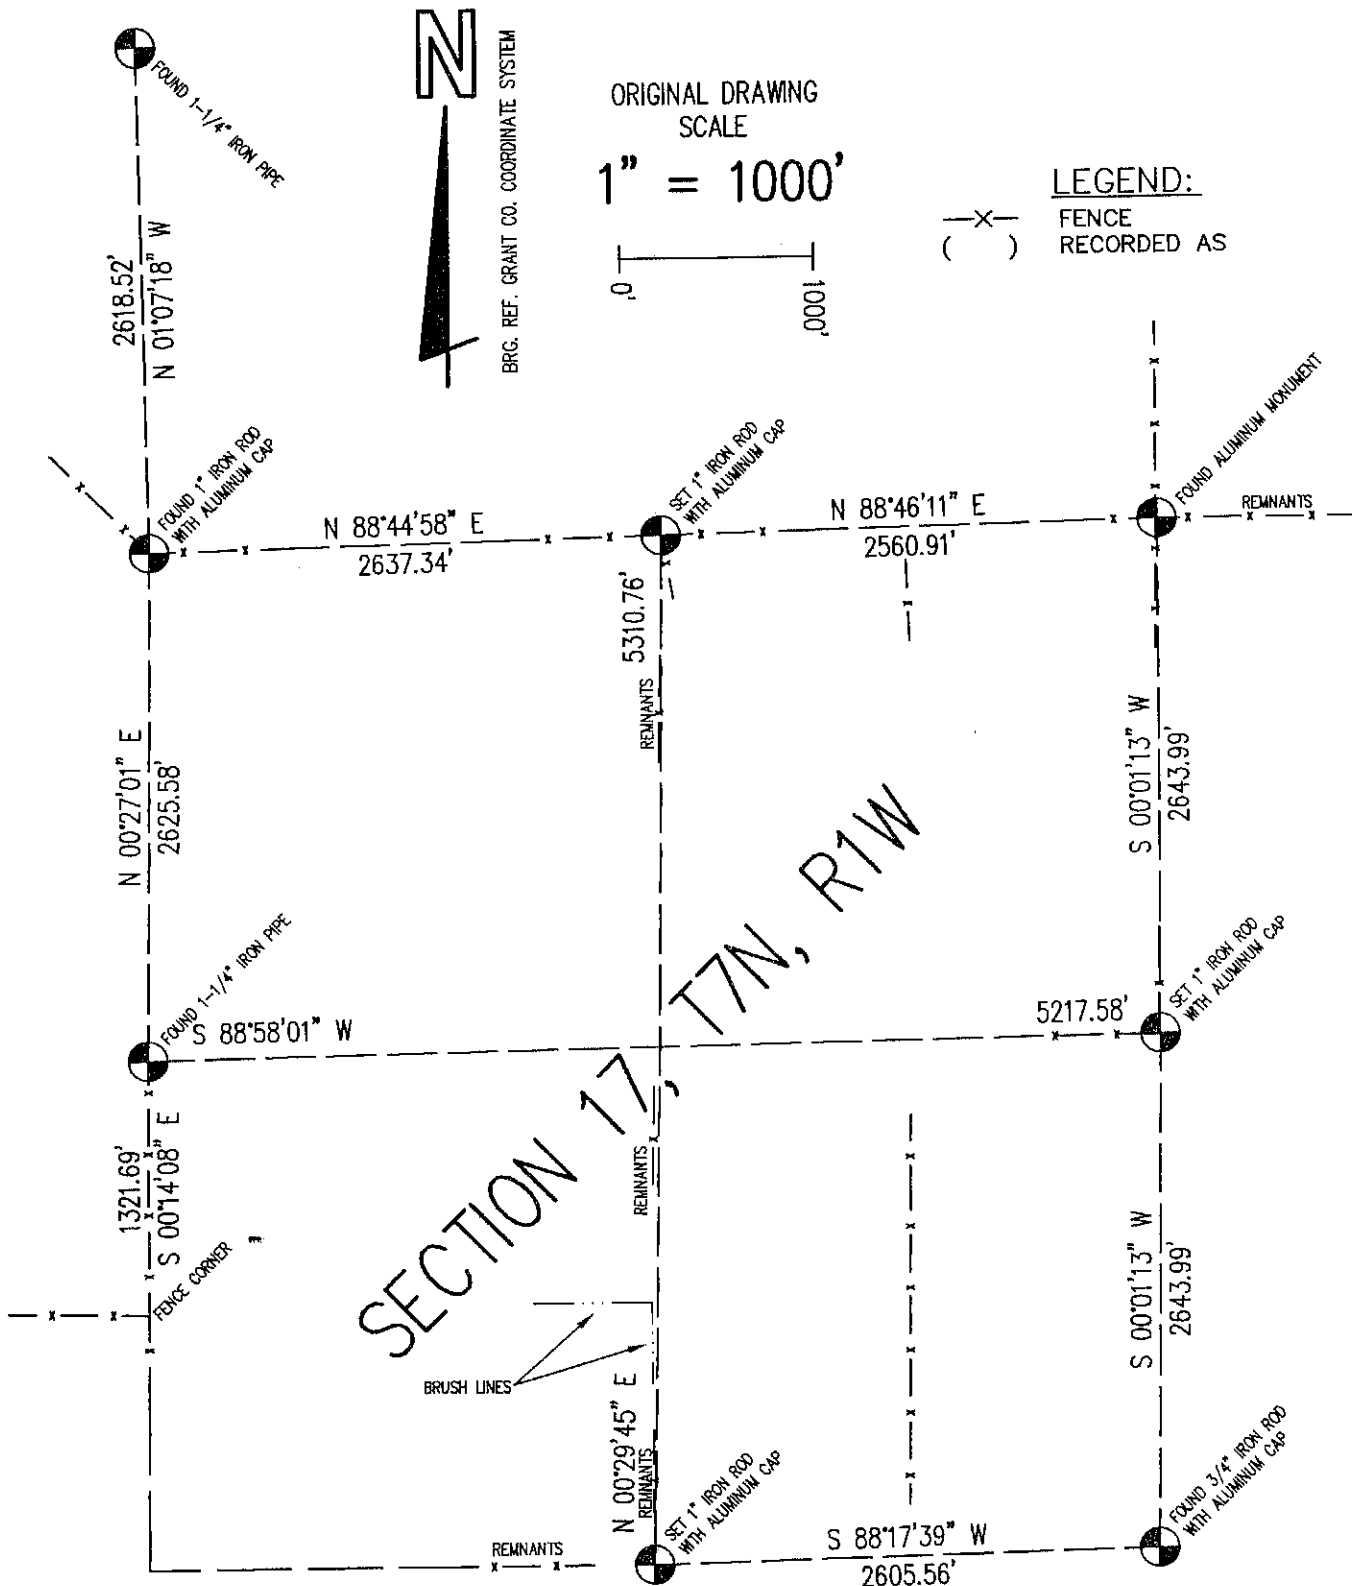

Michael R. LaRosa 4/13/2004
Michael R. LaRosa RLS S-2259 Date

M. R. LaROSA TECHNICAL SERVICES

P.O. BOX 383 (263 E. MAIN ST.)

LINDEN, WISCONSIN 53553

TEL. 608-623-3000