
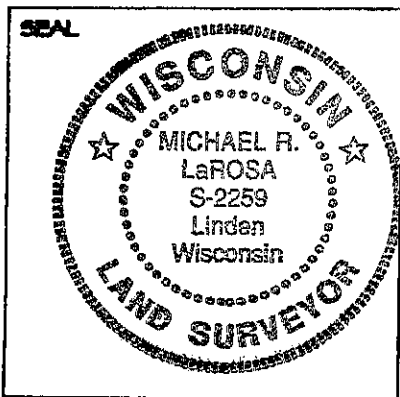


# SECTION SUMMARY SHEET

SECTION 19 T 7 N R/W

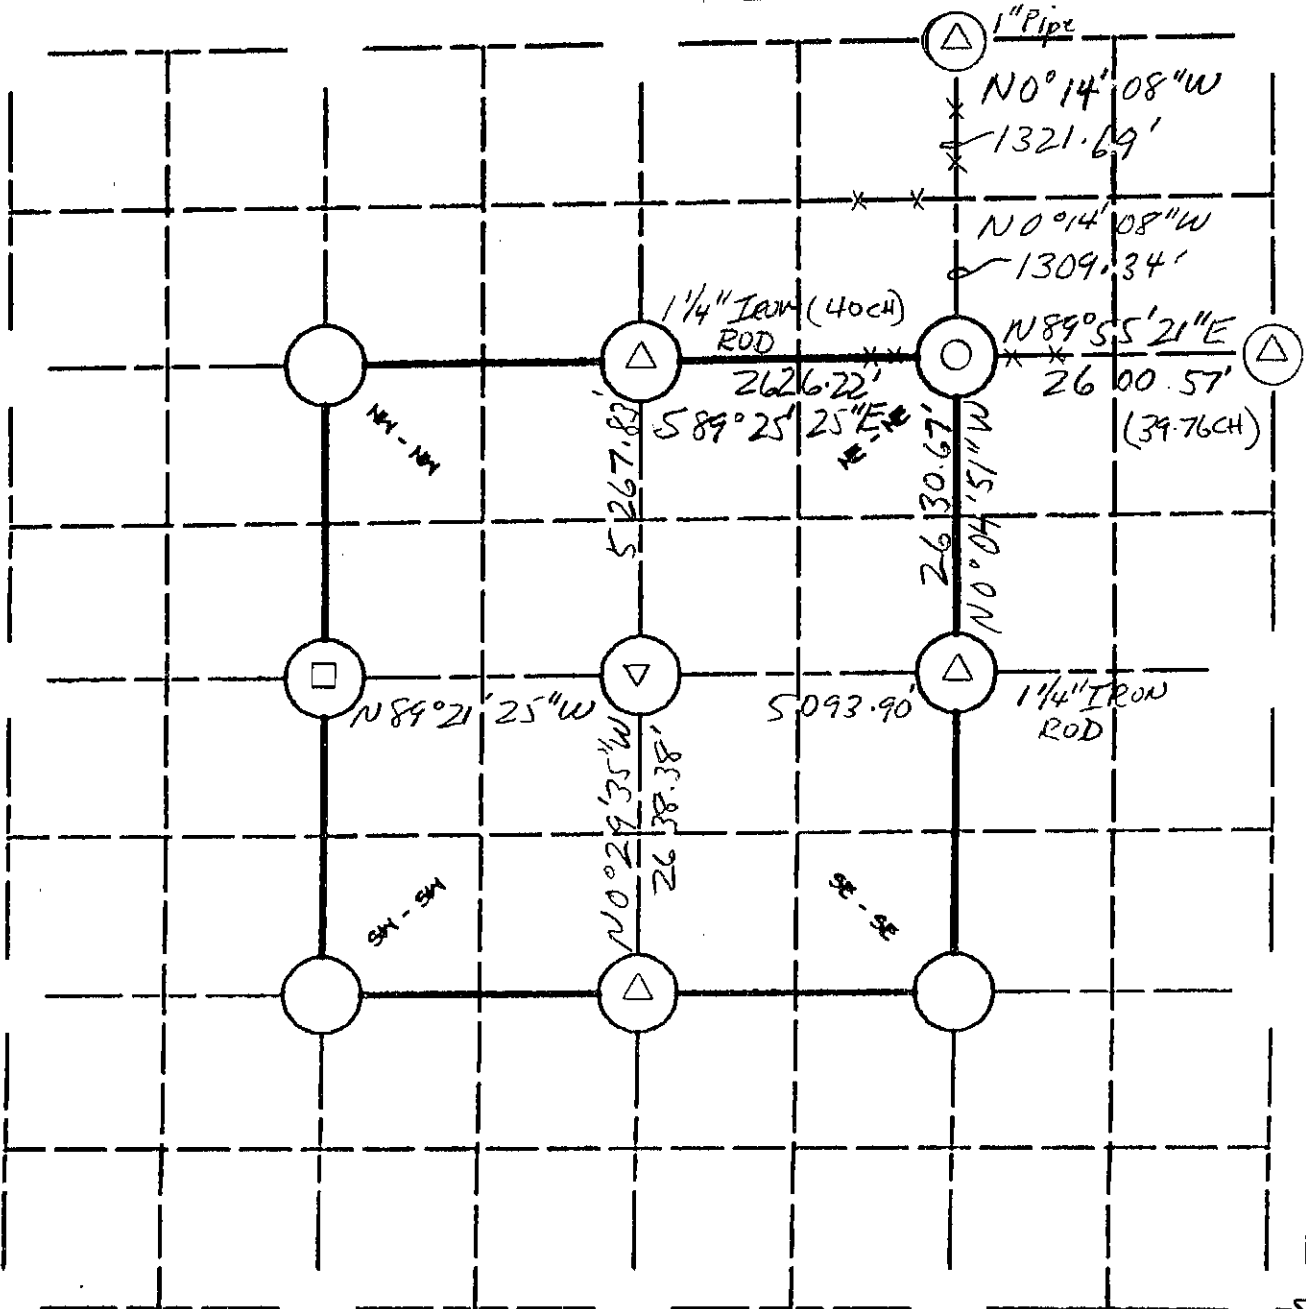

### LEGEND:

- COUNTY MONUMENT SET
- COUNTY MONUMENT FOUND or as noted
- OTHER (Specify) STONE MONUMENT FOUND
- OTHER (Specify) 1" IRON PIPE SET
- OTHER (Specify) \_\_\_\_\_
- OTHER (Specify) \_\_\_\_\_
- BEARING REF. \_\_\_\_\_

Grid North  
 Grant Co. Coord. Sys.

Michael R. LaRosa  
*Michael R. LaRosa*  
 1/19/2006

SIGNATURE \_\_\_\_\_ DATE \_\_\_\_\_

Horiz. Datum <input type="checkbox"/> NAD 27 <input type="checkbox"/> NAD 83(11) Units <input type="checkbox"/> ENGLISH <input type="checkbox"/> Metric Co-ordinate System <input type="checkbox"/> Geodetic <input type="checkbox"/> State Plane (S. zone) <input type="checkbox"/> Lat. County	The information provided in this box is not req'd, but requested to be provided if available to the surveyor preparing this sheet; otherwise provide reference in accordance with survey plat related to preparation of this sheet.  Place coordinates furnished adjacent to the corner(s) on section sketch above.
---	---