


**U.S. PUBLIC LAND SURVEY MONUMENT RECORD – GRANT COUNTY, WI**

**Summary of Section 33, Town 7 North, Range 1 West, Town of Castle Rock**

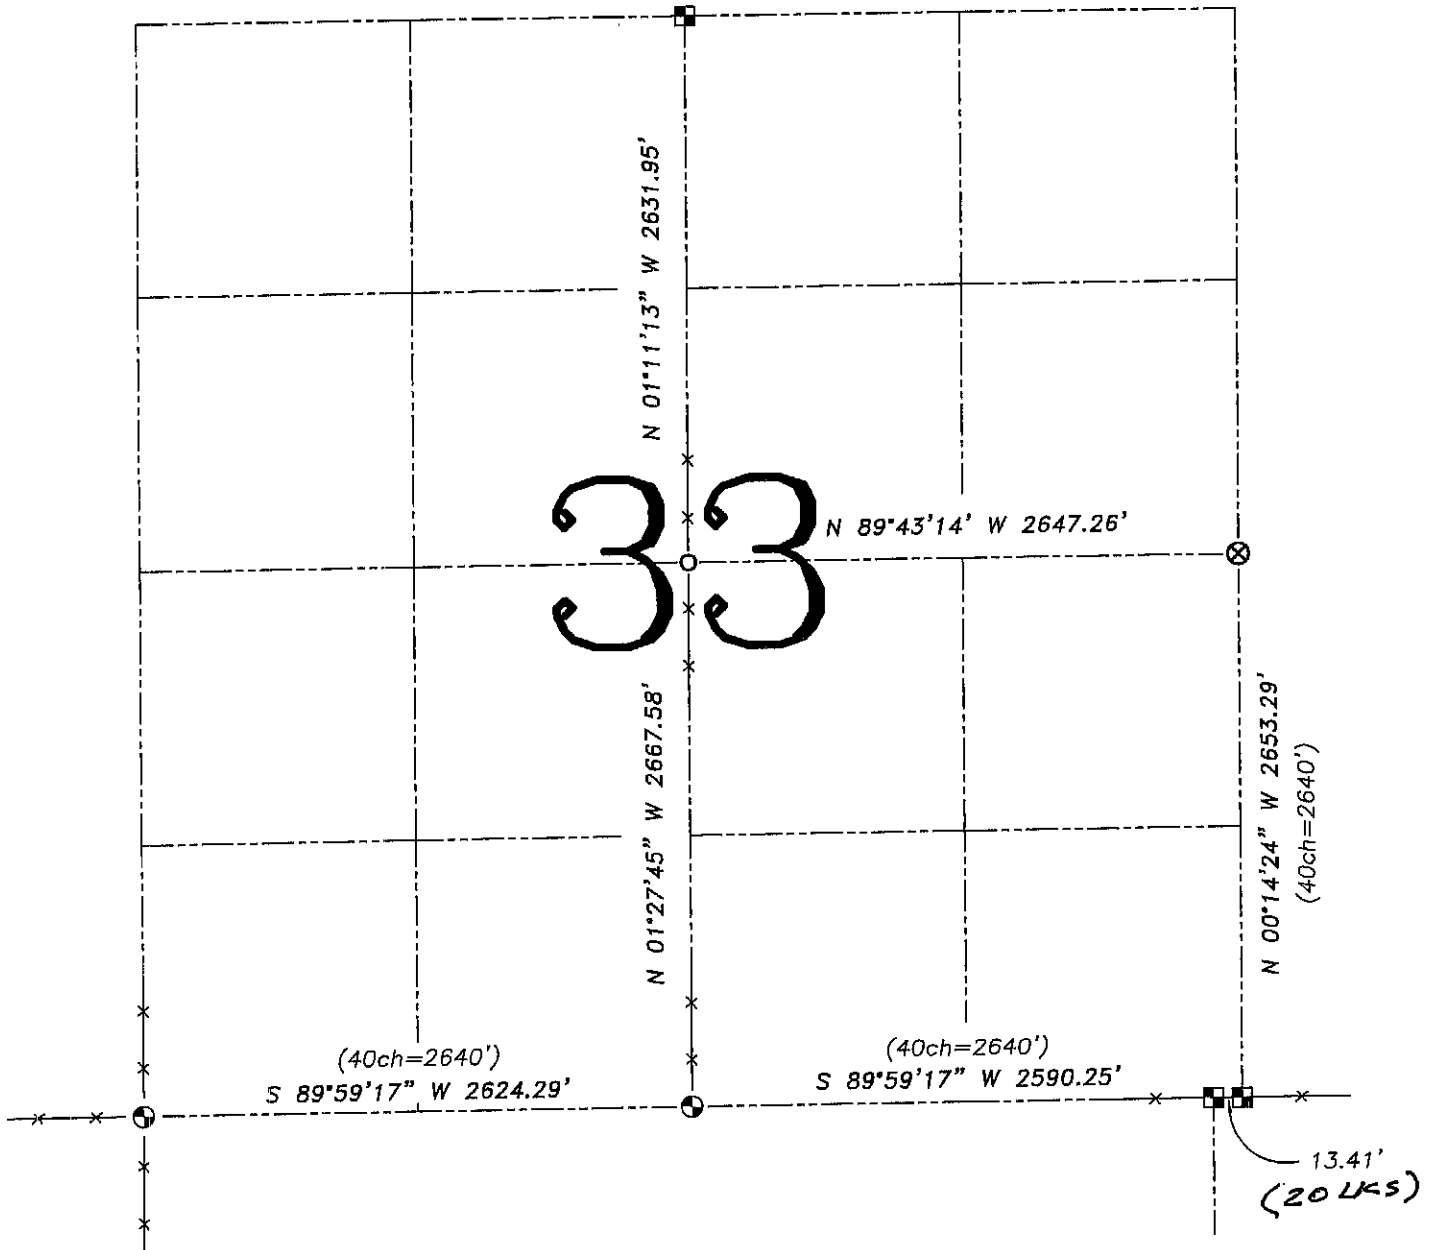

**LEGEND**

- ⊗ No. 6 rebar found with Grant County Aluminum Cap
- ⊕ No. 8 x 30" rebar set with Grant County Aluminum Cap
- No. 6 rebar found
- Aluminum Monument found with Grant County Aluminum Cap
- ( ) Recorded as
- x— Approximate location of existing fence



Relationship of all section corners to other section corners shall be shown hereon by bearing and distance or grid coordinates. Bearing reference shown below.


Dated this 19th day of August, 2005

*Larry L. Austin*  
Larry L. Austin S-190



Bearings referenced to the South line of the Southwest Quarter of Section 33, which is assumed to bear S 89°59'17" W

SKETCH NOT TO SCALE

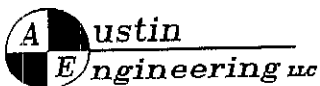

4211 HWY 81 E, LANCASTER, WI 53813  
PHONE 608-723-6363 FAX 608-723-6702

JOB NUMBER: 05s068  
FIELDBOOK: TDSR  
G:\T7NR1W\29  
H:\TIE\T7NR1W\33SUM

DRAWN BY: ML DIGMAN  
APPROVED: LL AUSTIN