


SECTION CORNER TIE SHEET INDEX

T. 7 N., R. 2 W

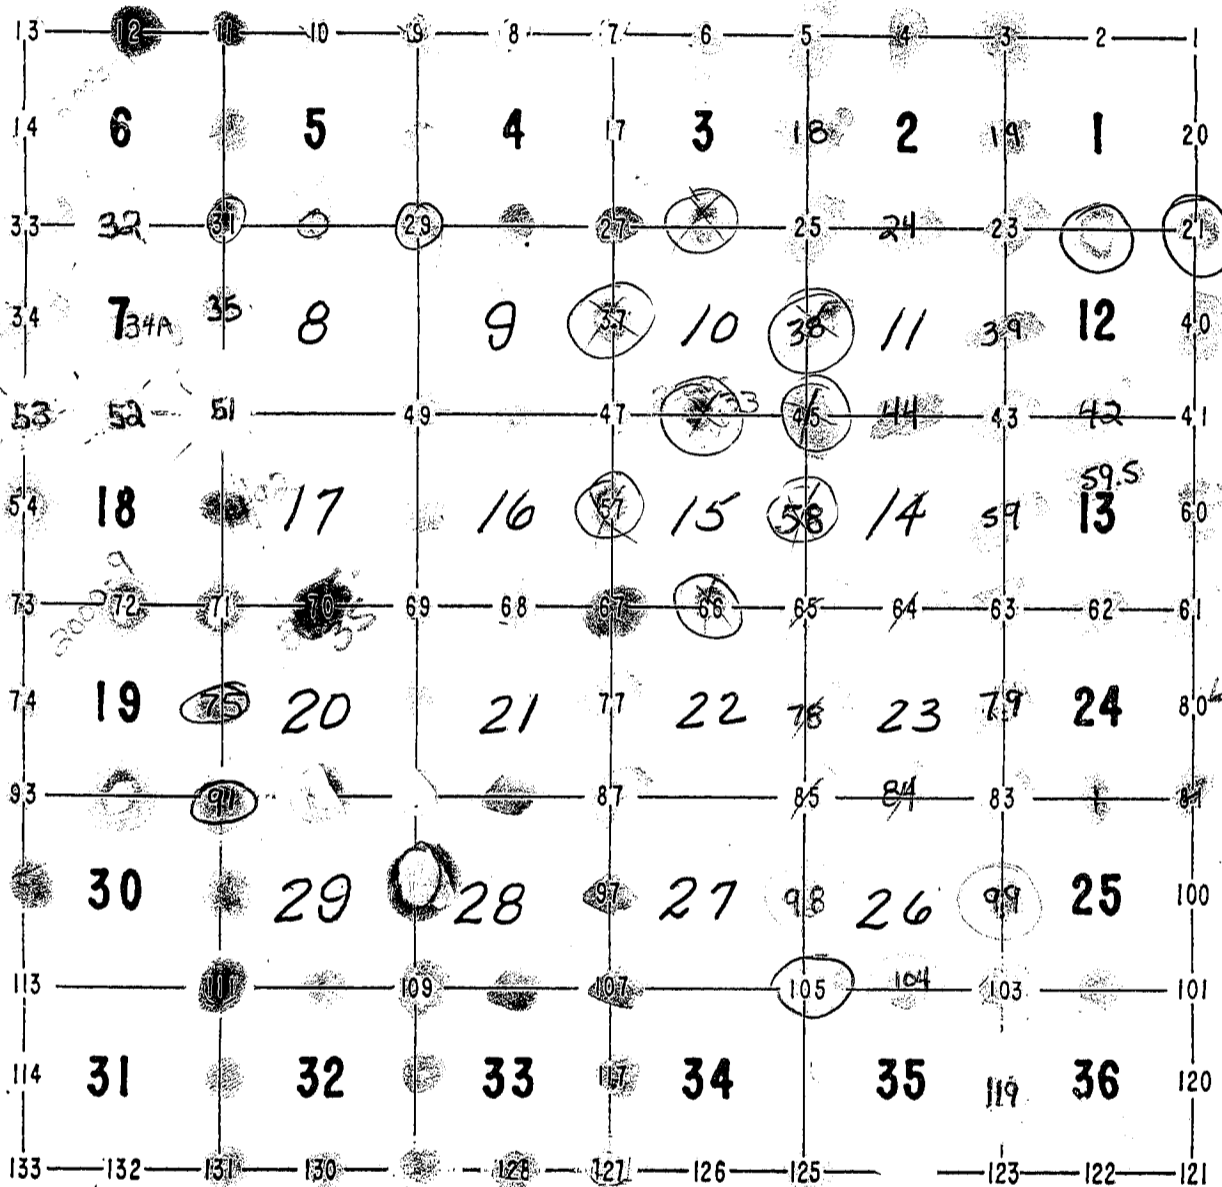

102-1-06

106

58 10/99