

OCT 15 2016

GOVERNMENT CORNER RECORD

N.E. CORNER, SECTION 8, TOWNSHIP 7 NORTH, RANGE 2 ~~EAST~~-WEST,
 TOWN, CITY OR VILLAGE OF HICKORY GROVE, GRANT COUNTY
 TYPE OF MONUMENT: 3/4" x 24" IRON ROD ELEVATION - M.S.L. DATUM _____


WITNESSES TO CORNER LOCATION

SEAN WALSH

GARY POLLOCK

SECTION 8, T 7 N, R 2 ~~EW~~

TOWN OF HICKORY GROVE

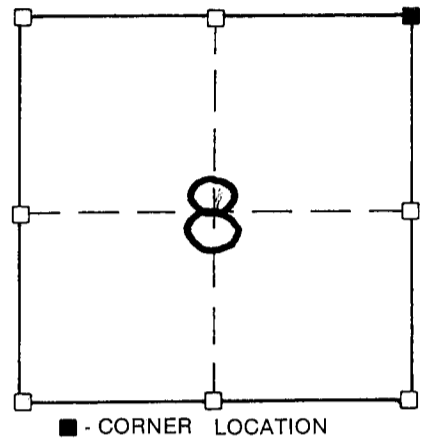

TIE SKETCH
(SHOW ALL HELPFUL FEATURES)

FIELDS

o 3/4" x 24" IRON ROD SET

x-x-x FENCELINE

I.R.S. BURIED ± 12"

I.R.S. BURIED ± 12"

48.02'

37.38'

50.96'

53.90'

I.R.S.

I.R.S.

PASTURE

SURVEYOR'S CERTIFICATE

SEAL S. 2016

I, Sean M. Walsh, DO HEREBY CERTIFY THAT I have established the
above corner at the location shown hereon, being the location
of physical occupation, this location fits very well with
previously recorded information for the section line to the
and fits very well with the described properties in the area
and that the above information is correct to the best
information, knowledge and belief.

DATED THIS 23RD DAY OF September, 1991

Sean M. Walsh
 REGISTERED LAND SURVEYOR

